


FINAL PROOF SURVEY MAP

IN THE NAME OF JAMES W. VAN LOAN



APPLICATION S-70000

PERMIT 52756

SECTIONS 31 & 32, TOWNSHIP 25½ SOUTH, RANGE 1 EAST, W.M.

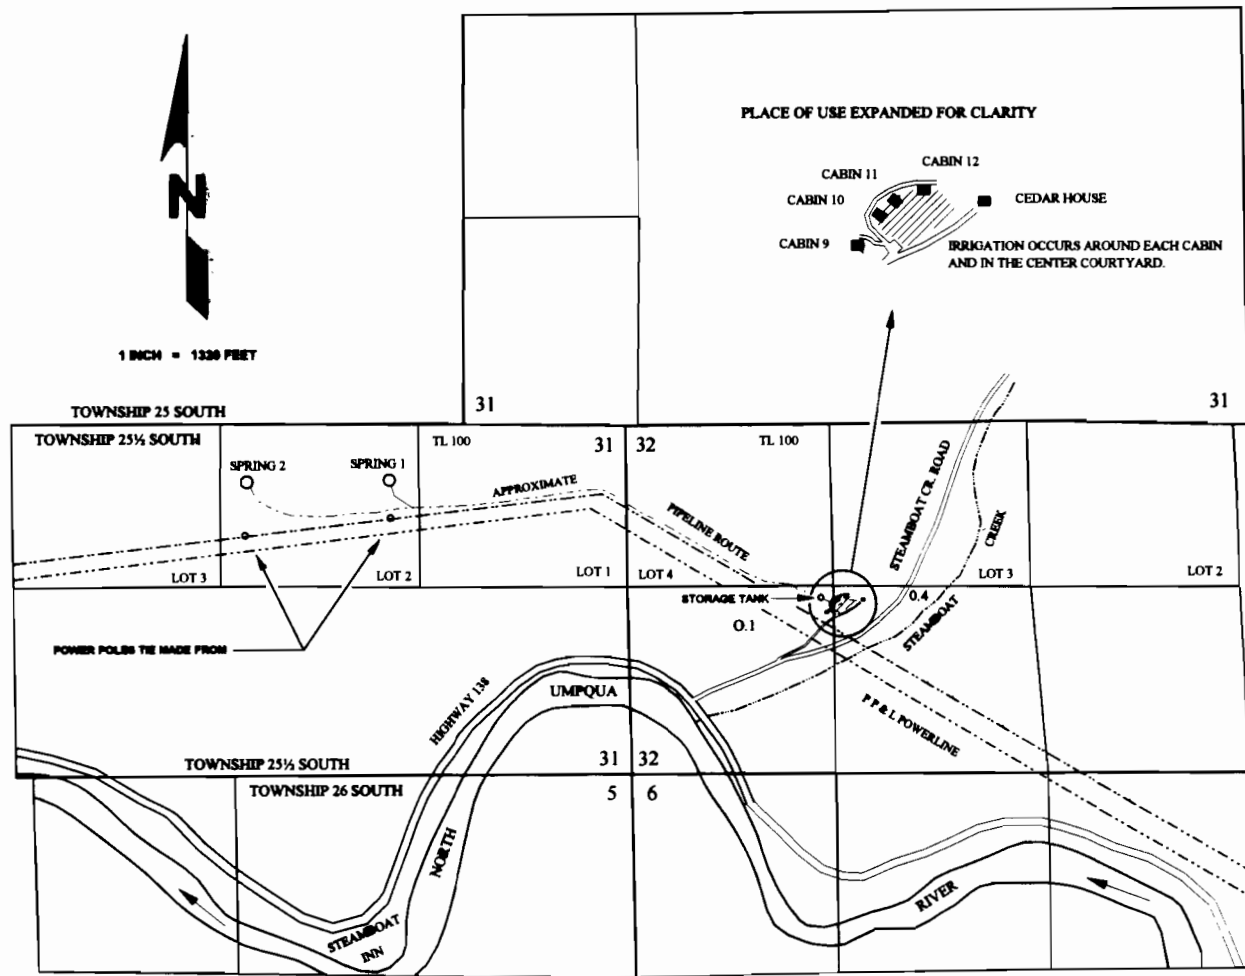

SPRING No. 1 IS LOCATED 370 FEET SOUTH AND 1,630 FEET WEST AND SPRING No. 2 IS LOCATED 390 FEET SOUTH AND 2,610 FEET WEST, BOTH FROM THE NORTHEAST CORNER OF SECTION 31 AND WITHIN THE NW¼NE¼ (LOT 2) OF SECTION 31, TOWNSHIP 25½ SOUTH, RANGE 1 EAST, W.M.; DOUGLAS COUNTY.

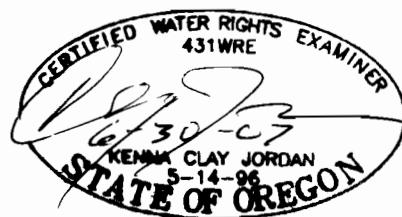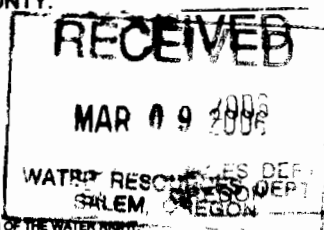

THE PURPOSE OF THIS MAP IS TO IDENTIFY THE LOCATION OF THE WATER RIGHT.
IT IS NOT INTENDED TO PROVIDE INFORMATION RELATIVE TO THE LOCATION OF
PROPERTY OWNERSHIP BOUNDARY LINES.