


RECEIVED

T. 17 S. R. 3 E. W.M.

OCT 17 1996

SW 1/4 NE 1/4 SECTION 2 Tax Lot 1200

WATER RESOURCES DEPT.
SALEM, OREGON

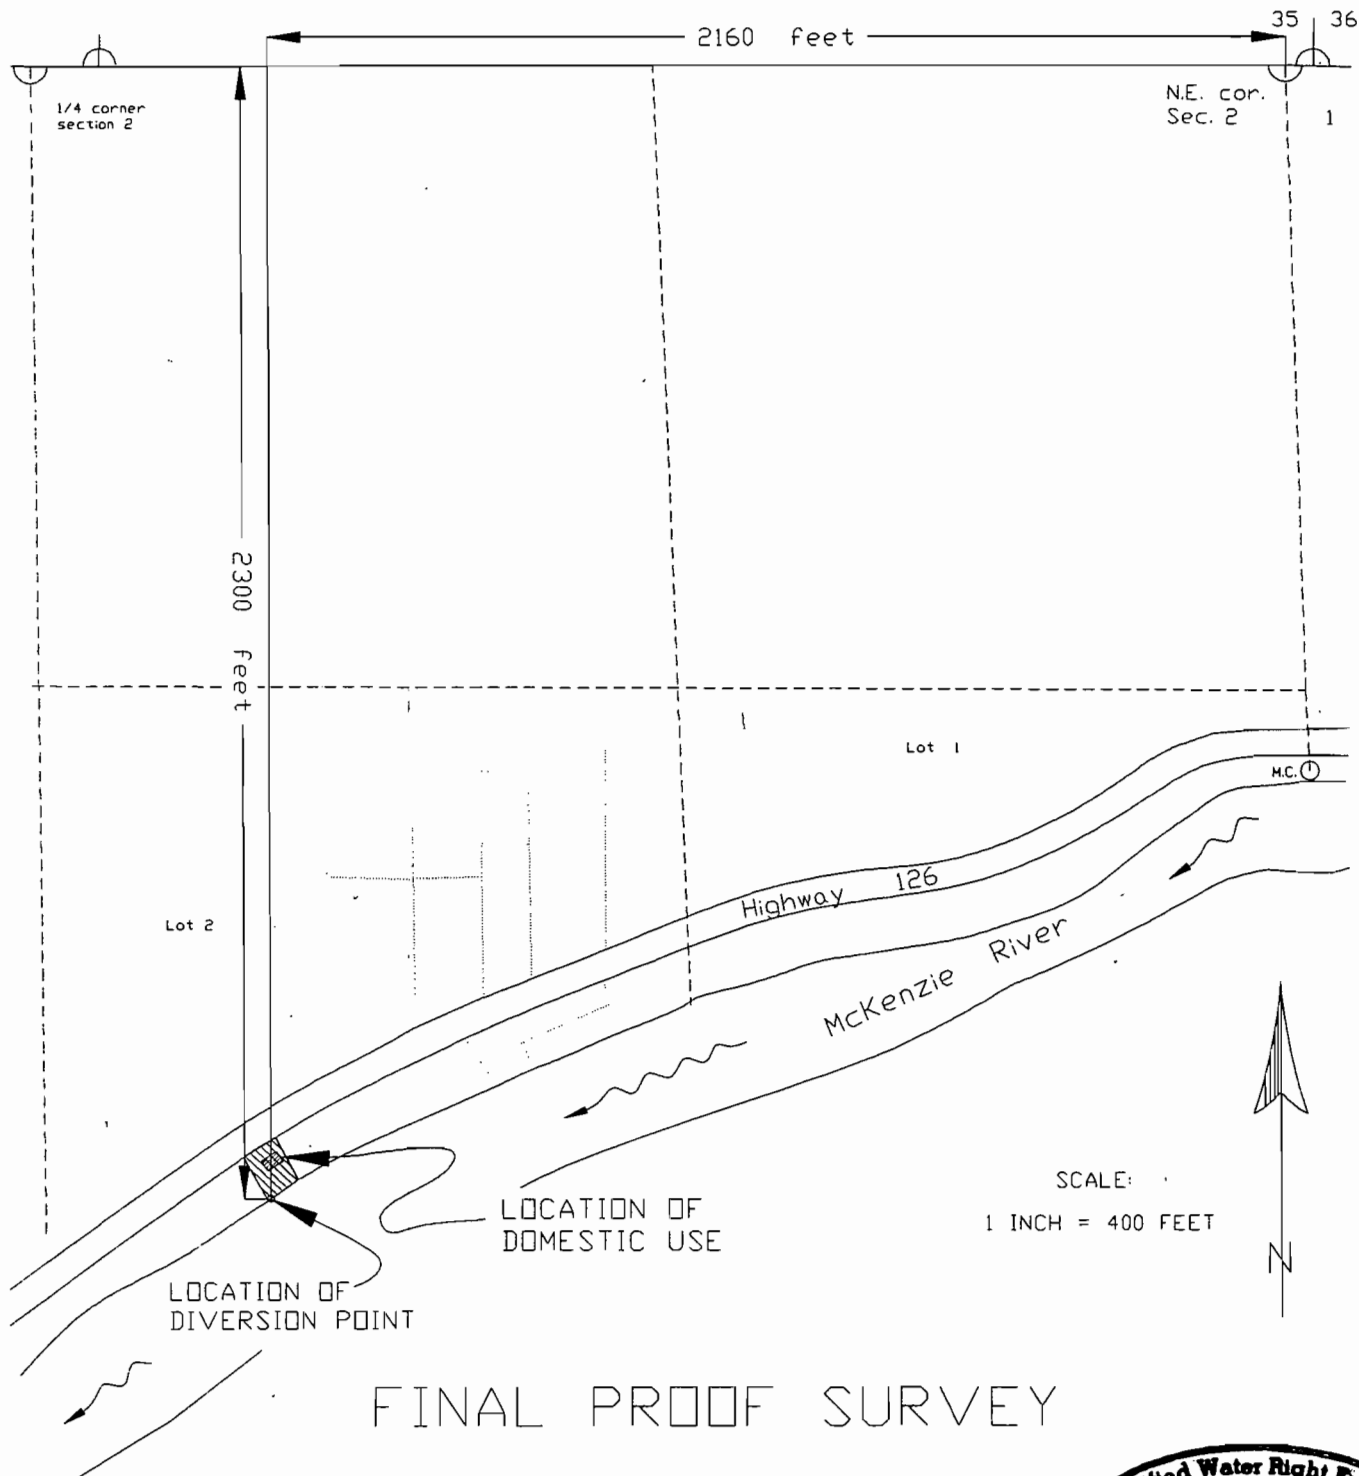

FINAL PROOF SURVEY

UNDER APPLICATION NO. 72250
PERMIT NO. 51576

IN THE NAME OF: LEROY KLEMM

SURVEYED MARCH 23, 1996

Note: This map is for the purpose of identifying the location of the water right only and is not intended to provide legal dimensions or location of property ownership lines.

