



SECTIONS 20, TWP.1 N. RANGE 14 E. W.M.
 WASCO COUNTY, OREGON

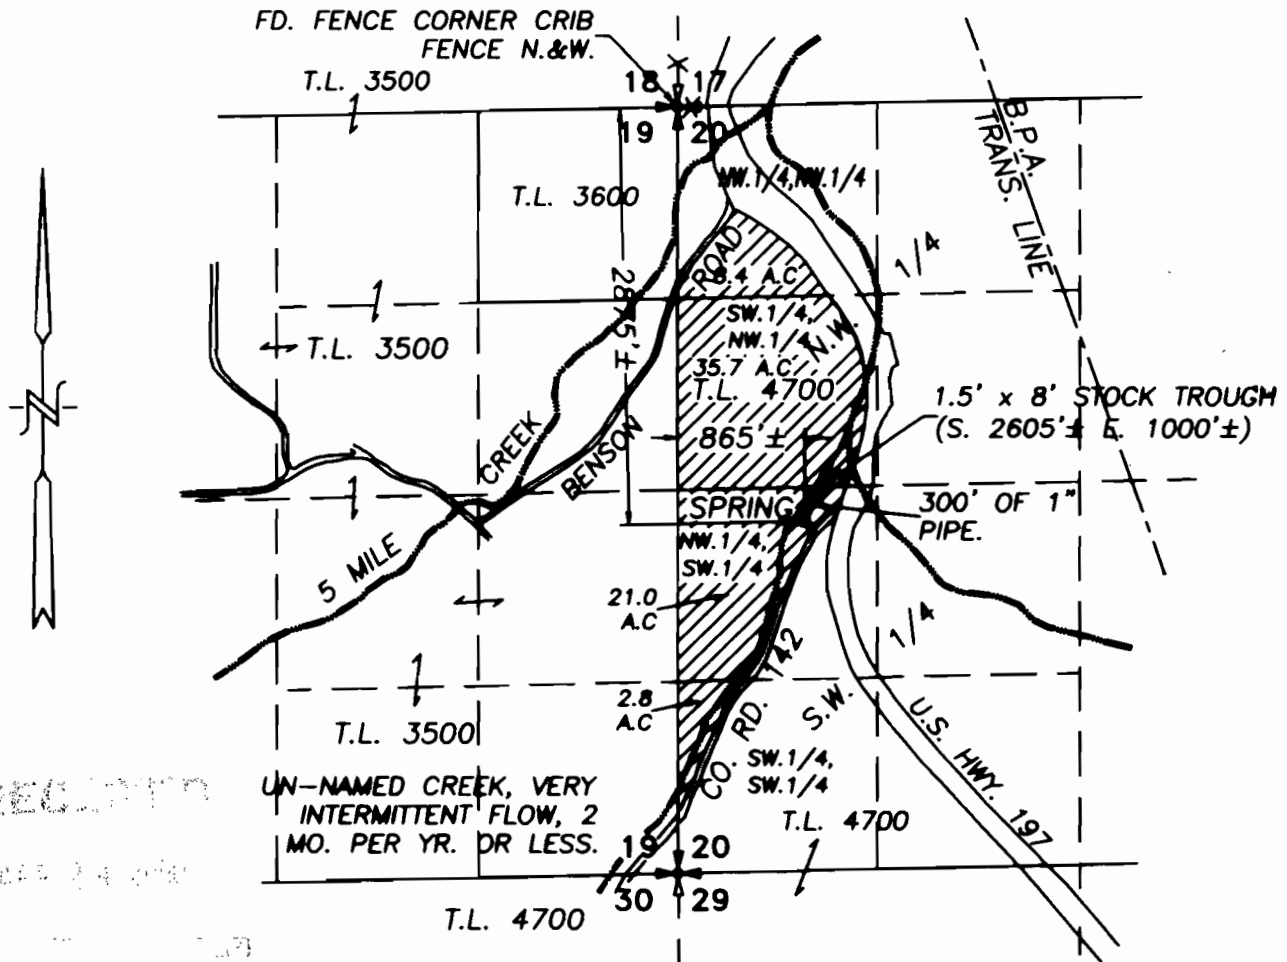

RECEIVED

**WATER RIGHT FINAL PROOF SURVEY MAP
 FOR STOCK WATERING**

SCALE: 1" = 1320'

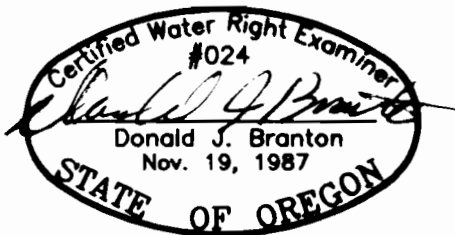

RENEW: 12/31/01

NOTE:

THE WATER RIGHT ONLY AND IS NOT INTENDED TO PROVIDE DIMENSIONS OR LOCATE PROPERTY OWNERSHIP LINES.

CERTIFICATE No. S-71376

PERMIT No. 52452

IN THE NAME OF:
SYLVIA R. WEIMAR-OGREN & DOUGLAS WEIMAR

DATE: APRIL 20, 2000

BY: TENNESON ENGINEERING CORP.
 409 LINCOLN STREET,
 THE DALLES, OREGON. 97058
 PH. (541) 296-9177
 FAX (541) 296-6657