



T.36 S. R.07 W. SEC. 2

RECEIVED

JUL 28 1998

FINAL PROOF SURVEY  
IN NAME OF  
PAUL H. & KATHLEEN BELTIS

WATER RESOURCES DEPT.  
SALEM OREGON

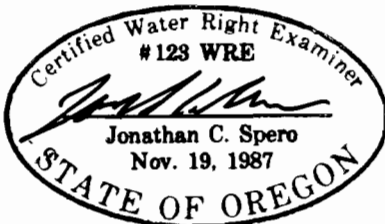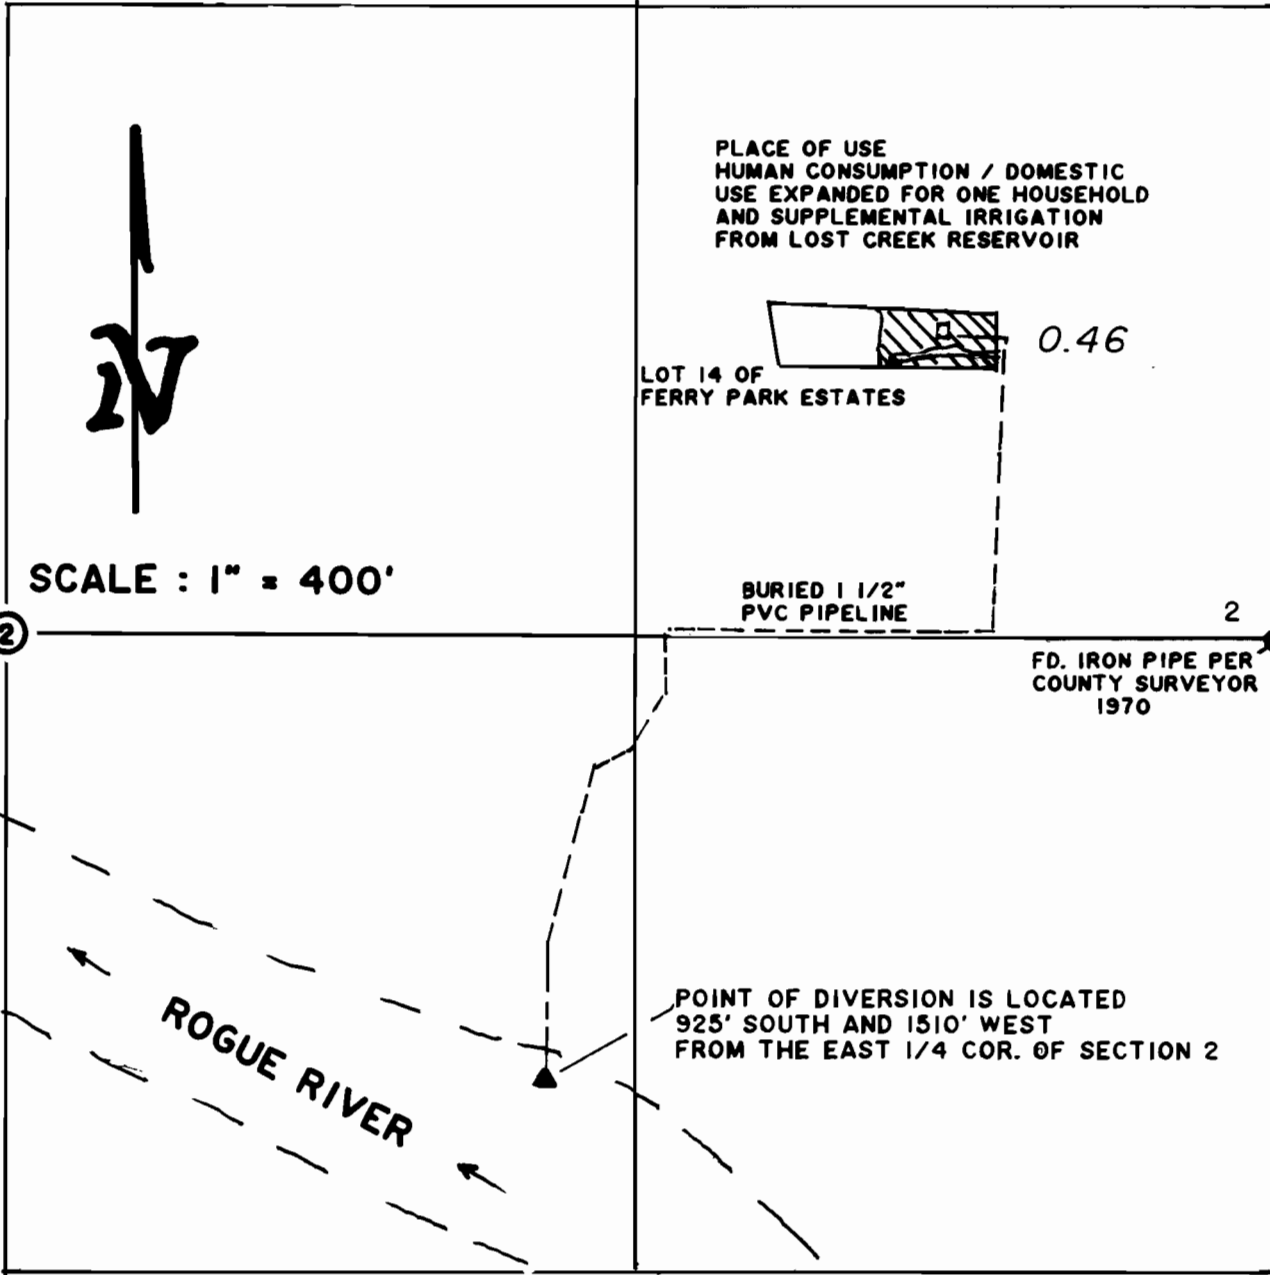

SURVEYOR'S REGISTRATION LICENSE  
RENEWAL DATE: JUNE 30, 2000

UNDER  
APPLICATION No. 71999  
PERMIT No. 51530

SURVEYED JULY 14, 1998  
BY JONATHAN C. SPERO

PREPARED BY:  
JONATHAN C. SPERO C.W.R.E. 123  
1002 KINCAID RD./P.O. BOX 16  
WILLIAMS, OREGON 97544  
PH. (541) 846-6845

THIS MAP IS FOR THE PURPOSE OF  
IDENTIFYING THE LOCATION OF THE  
WATER RIGHT ONLY, AND IS NOT  
INTENDED TO PROVIDE LEGAL DIMEN-  
SIONS OR LOCATIONS OF PROPERTY  
OWNERSHIP LINES.