


RECEIVED

T.33S.,R.2E.,W.M.

APR 23 1999

WATER RESOURCES DEPT.  
SALEM, OREGON

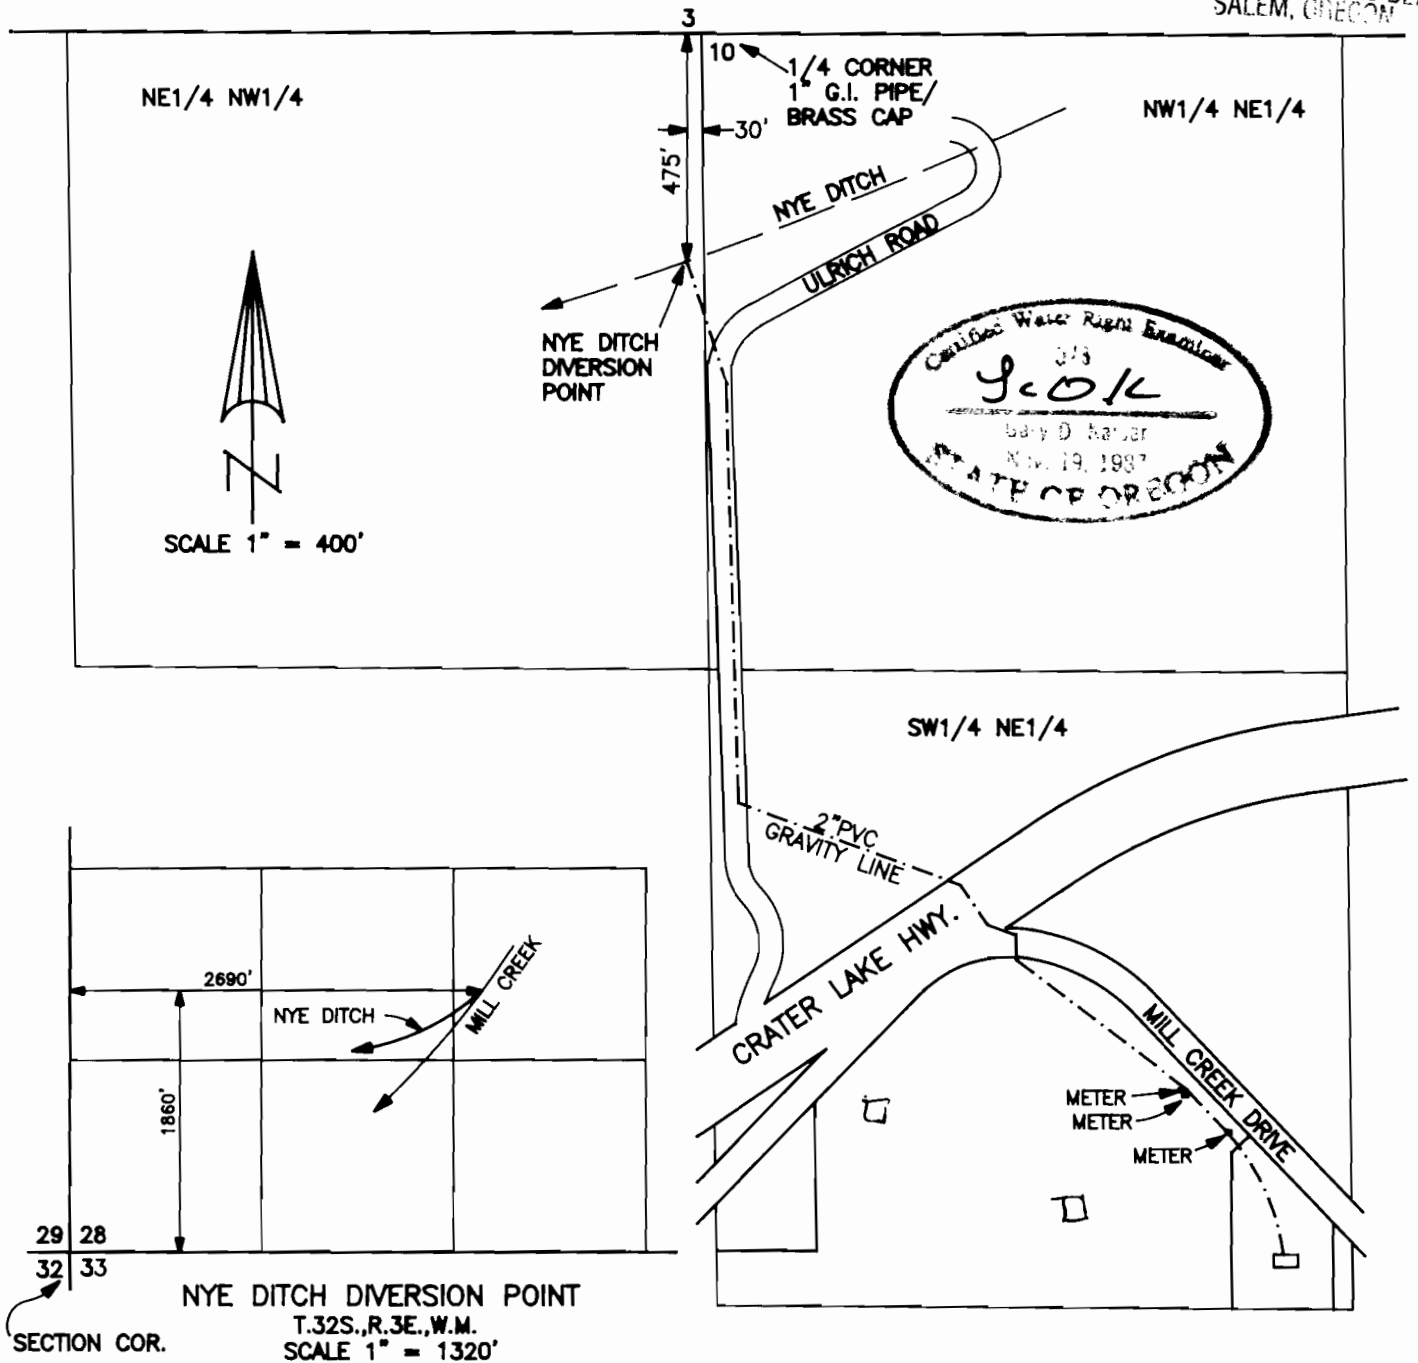

FINAL PROOF MAP

APPLICATION No. S-72329  
PERMIT No. 52144

IN THE NAME OF  
THOMAS W. LASSETT,  
DAVID D. REEDER M.D. and FRANK J. GLEICH

NOTE: MAP PREPARED FOR  
WATER RIGHT PURPOSES ONLY,  
NOT FOR PROPERTY BOUNDARY  
LOCATIONS.

MAP PREPARED APRIL 12, 1999  
BY GARY D. KAISER