


RECEIVED

OCT 01 1998

WATER RESOURCES DEPT.
SALEM, OREGON

T13S. R11W., W.M.
NW1/4 - NE1/4 SECTION 18
LINCOLN COUNTY, OREGON

Scale: 1 inch = 400 feet

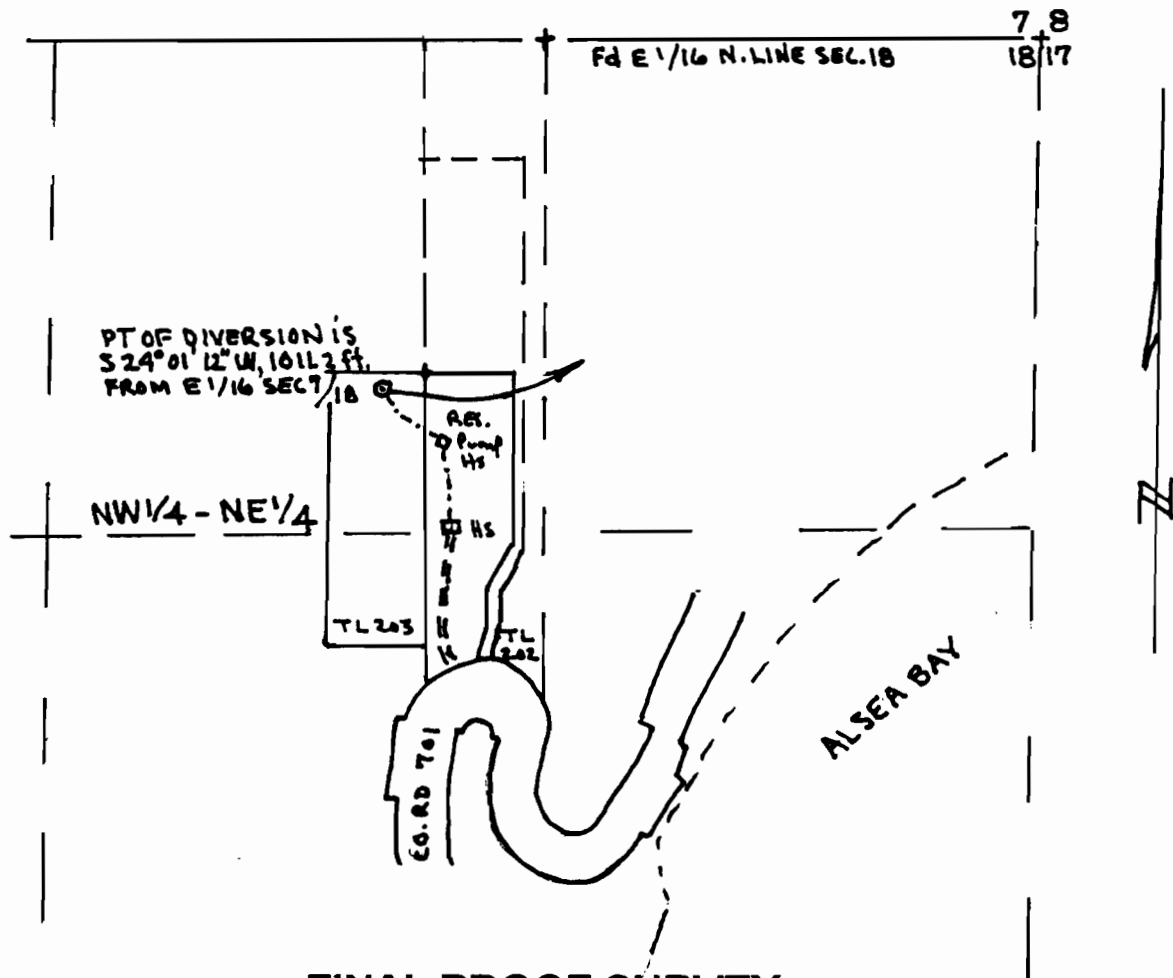

**FINAL PROOF SURVEY
UNDER**

APPLICATION # 73249

PERMIT # 51596

IN THE NAME OF

TED & KAREN HARBER

SURVEYED: September 30, 1998

BY: J. M. DENISON

THIS MAP PREPARED SOLEY FOR THE PURPOSE OF SHOWING LOCATION OF A WATER RIGHT, AND IS NOT INTENDED FOR USE FOR PROVIDE DIMENSIONS OR LOCATION OF PROPERTY OWNERSHIP LINES.

