

RECEIVED

JUN 15 1990


WATER RESOURCES DEPT
SALEM, OREGON

FINAL PROOF SURVEY

UNDER
APPLICATION # S-81068 PERMIT # 53243

IN THE NAME OF


LATOURELL FALLS WATER DISTRICT INC.

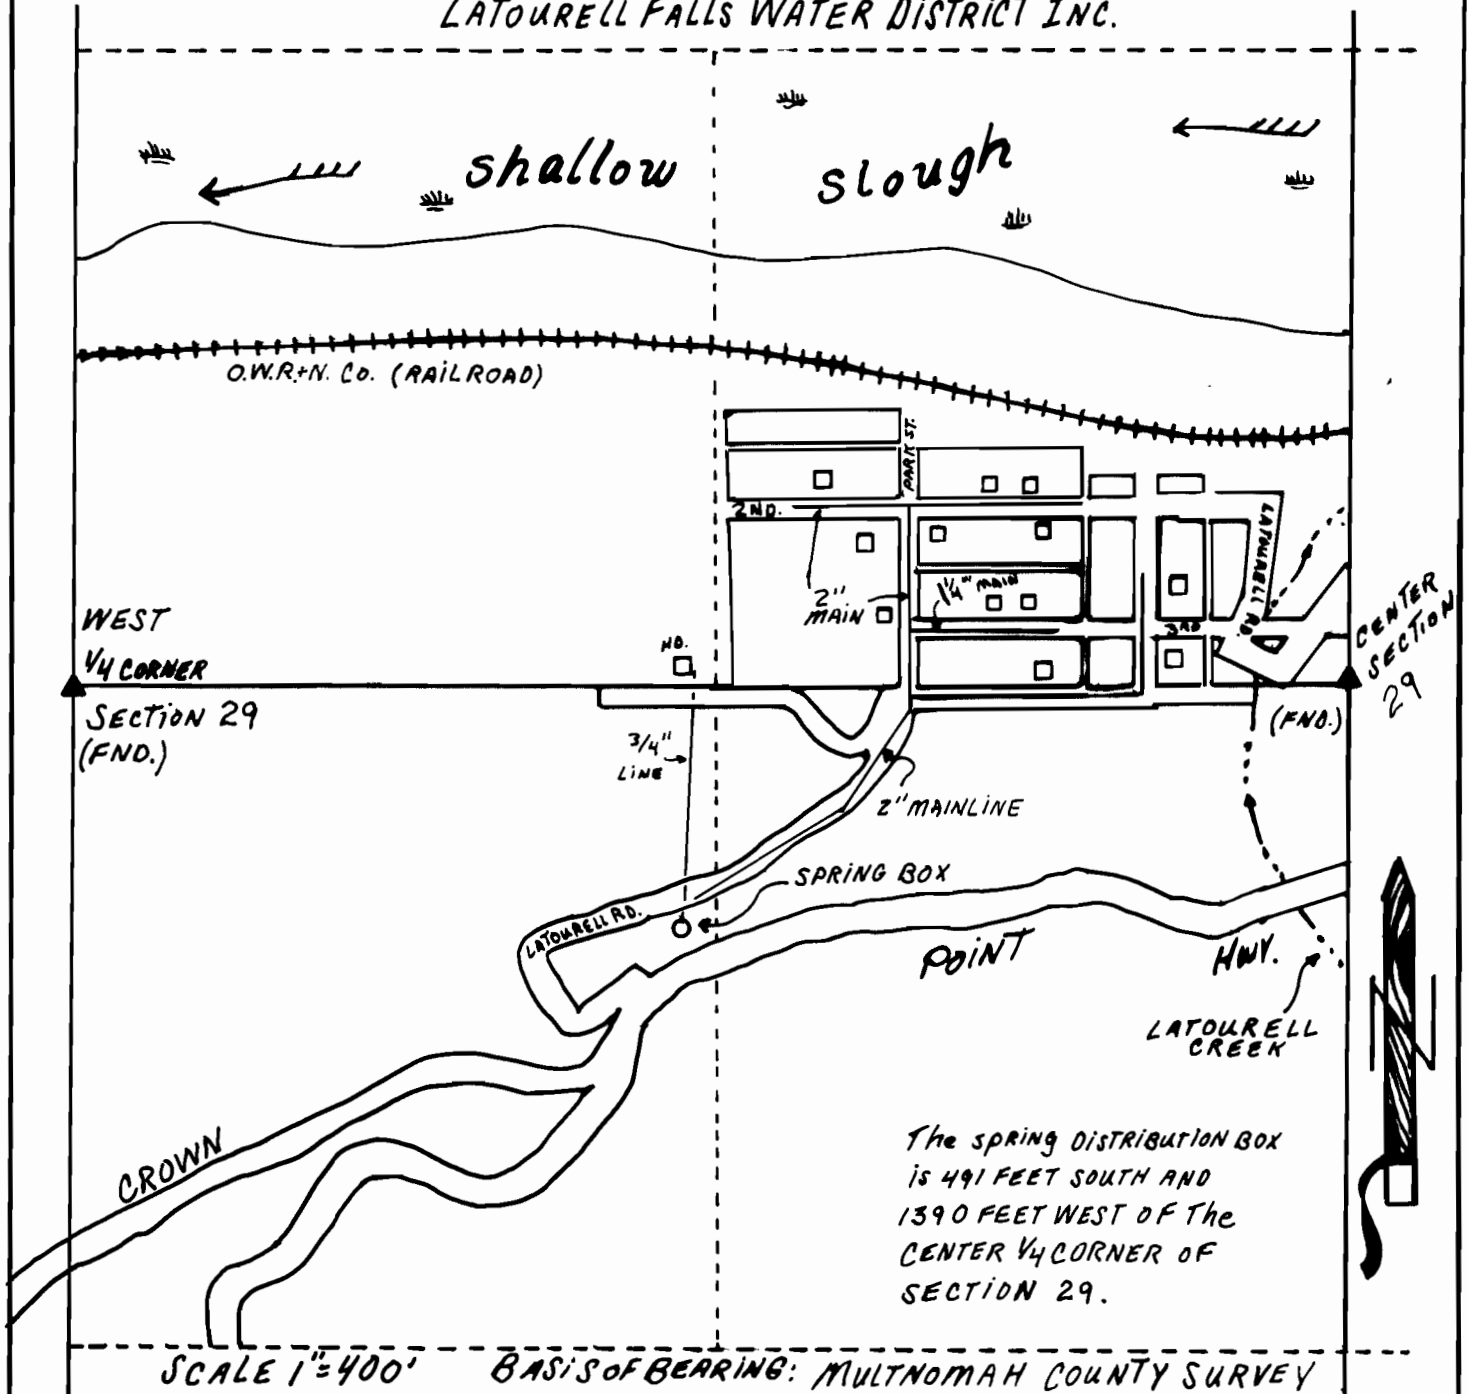

The spring DISTRIBUTION BOX
is 491 FEET SOUTH AND
1390 FEET WEST OF THE
CENTER $\frac{1}{4}$ CORNER OF
SECTION 29.

SCALE 1"=400'

BASIS OF BEARING: MULTNOMAH COUNTY SURVEY
RECORDS BOOK 3 PAGE 271

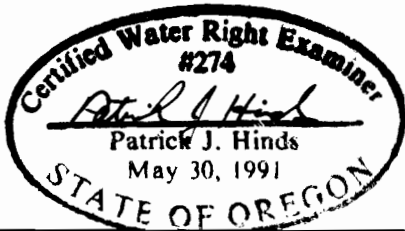

T.1N., R.5 E.
SECTION 29

SURVEYED APRIL 22, 1998