



T12S, R11W., W.M.
SECTION 20
LINCOLN COUNTY, OREGON

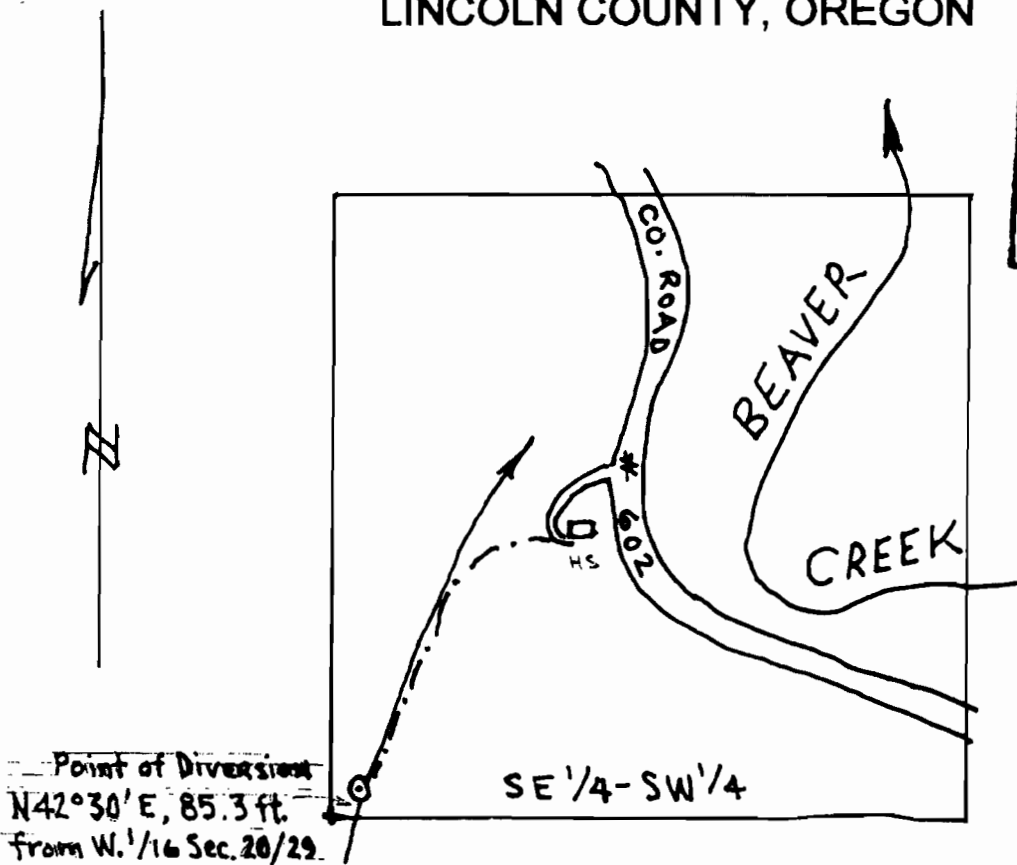

Scale : 1 inch = 400 feet

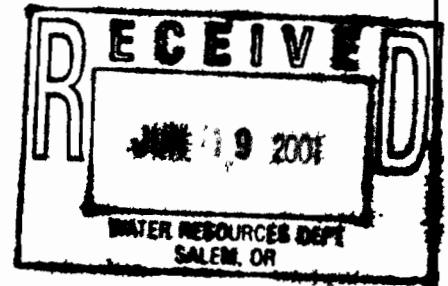

FINAL PROOF SURVEY
UNDER

APPLICATION # S-83784

PERMIT # 53623

IN THE NAME OF

David R. & Jean B. Young

SURVEYED: April 21, 2001

BY: James M. Denison

THIS MAP PREPARED SOLEY FOR THE PURPOSE OF SHOWING LOCATION OF A WATER RIGHT, AND IS NOT INTENDED FOR USE TO PROVIDE DIMENSIONS OR LOCATION OF PROPERTY OWNERSHIP LINES.

Final Proof Map