

**FINAL PROOF
WATER RIGHTS MAP
UNDER
PERMIT 51473**

**NW 1/4 NE 1/4, NE 1/4 NW 1/4, SEC. 27. T 17 S, R 10 W, W.M.
LANE COUNTY, OREGON.**

**FOR: MARVIN D. CONNELLY
1808 HWY. 36
MAPLETON, OR 97453**

**PREPARED BY: WOBBE & ASSOCIATES, INC.
510 KINGWOOD ST.
P.O. BOX 1136
FLORENCE, OR 97439**


RECEIVED
JUN - 6 1996

WATER RESOURCES DEPT.
SALEM, OREGON

RECEIVED

SEP 28 1995
WATER RESOURCES DEPT.
SALEM, OREGON

7-19-95
REVISED 6-4-96

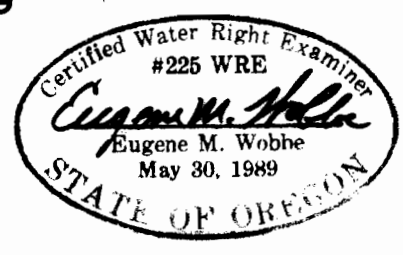

SCALE
1" = 400'