


TOWNSHIP 18 SOUTH, RANGE 6 WEST

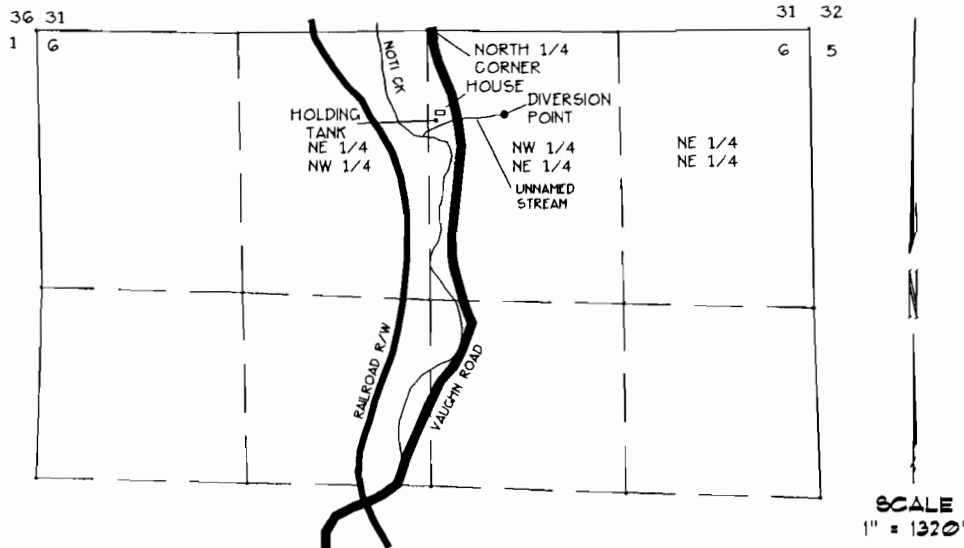

DIVERSION POINT
600 FEET SOUTH, AND
500 FEET EAST OF THE
NORTH 1/4 CORNER.
SECTION 6

APPLICATION 574687 PERMIT 52869


FINAL PROOF SURVEY

FOR


ELLEN ROBERTA BOEHRINGER
21888 VAUGHN ROAD
VENETA, OREGON 97487
541-935-2869

BY

FORD-NESS-FASSBENDER, INC.
PO BOX 22735
EUGENE, OREGON 97402
541-344-1852

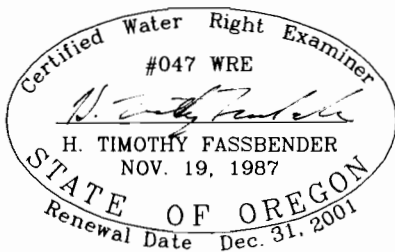

THIS MAP WAS PREPARED FOR THE
PURPOSE OF IDENTIFYING THE LOCATION
OF THE WATER RIGHT ONLY. IT IS NOT
INTENDED TO PROVIDE DIMENSIONS OR
LOCATION OF PROPERTY OWNERSHIP LINES.

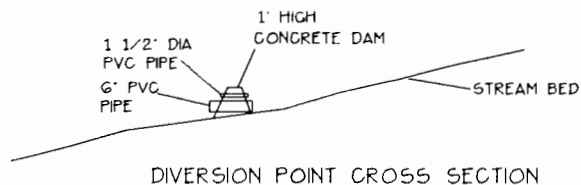

JOB NO. V2-912
DWG NO. V2-912.DWG

RECEIVED

SEP 07 2000

WATER RESOURCES DEPT
SALEM, OREGON