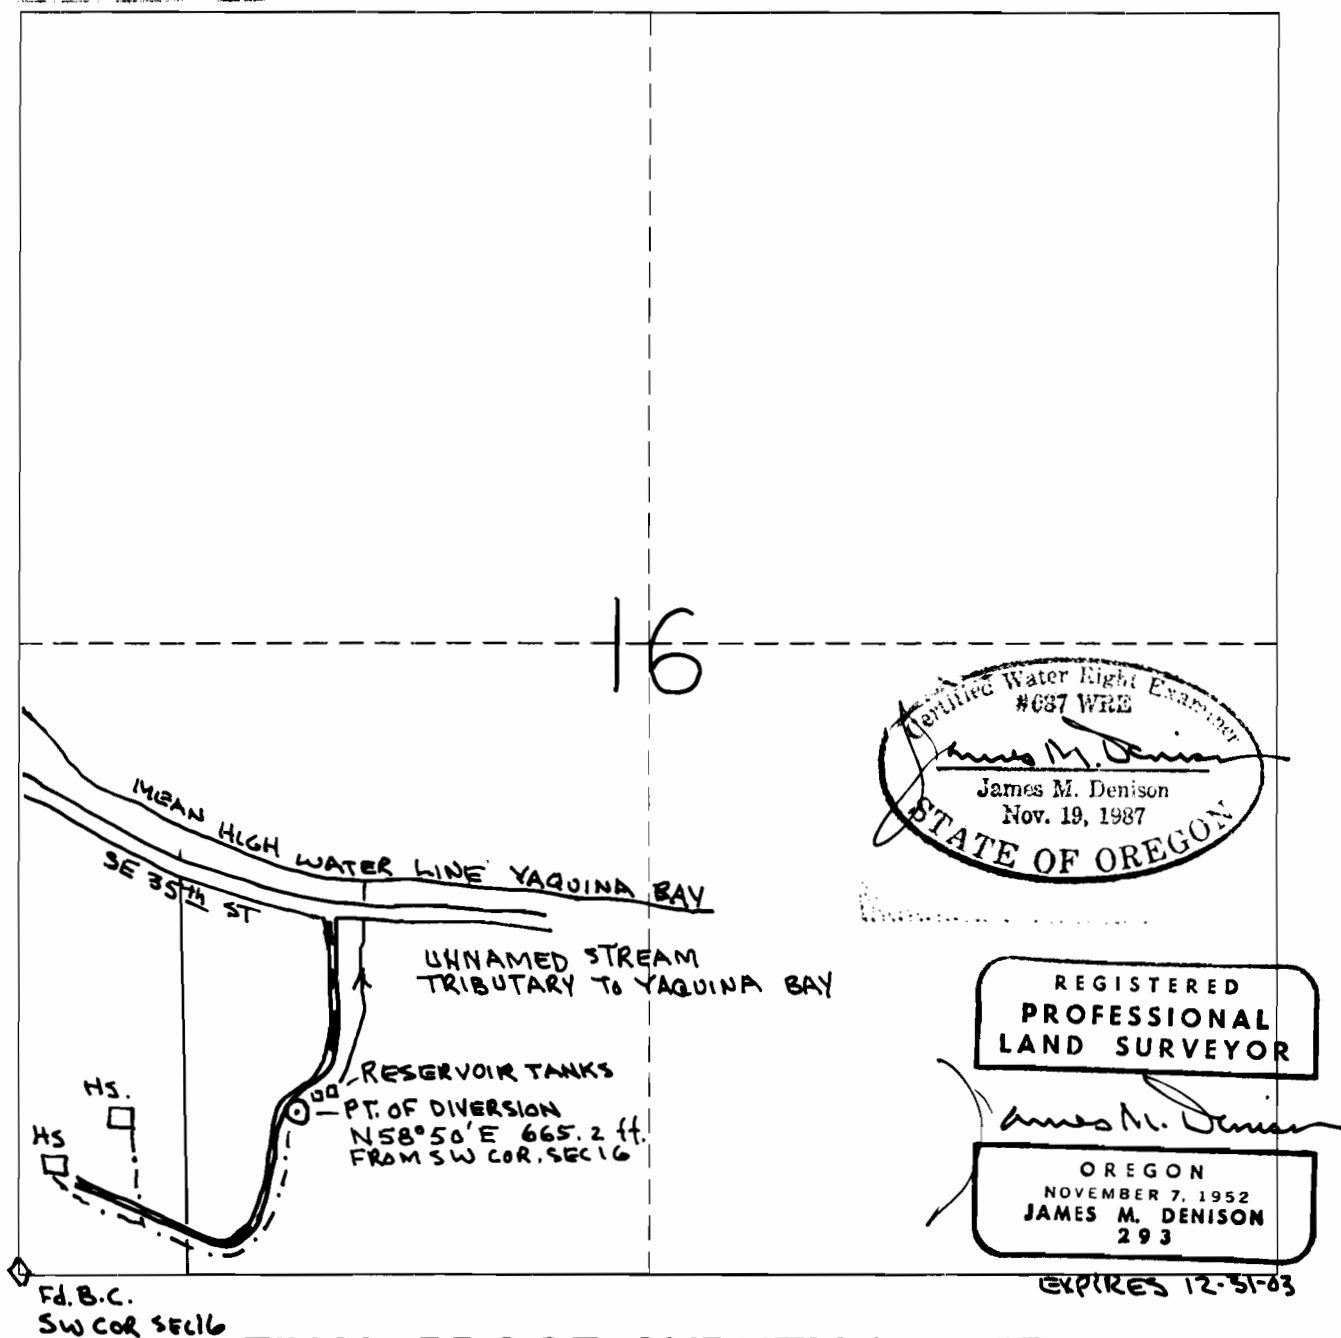


T11S, R11W, W.M.

SW 1/4 - SW 1/4 OF SECTION 16
LINCOLN COUNTY, OREGON

SCALE 1 inch = 400 feet

**FINAL PROOF SURVEY UNDER**

APPLICATION # S-84573

PERMIT # 53785

IN THE NAME OF
FRED YECK

SURVEYED: OCTOBER 7, 2002

BY: J. M. DENISON

THIS MAP PREPARED SOLEY FOR THE PURPOSE OF SHOWING LOCATION OF A WATER RIGHT, AND
IS NOT INTENDED FOR USE TO PROVIDE DIMENSIONS OR LOCATION OF PROPERTY OWNERSHIP LINES