


**T12S, R8W, W.M.  
SE 1/4 - SW 1/4 OF SECTION 1  
LINCOLN COUNTY, OREGON**

SCALE 1 Inch = 400 feet

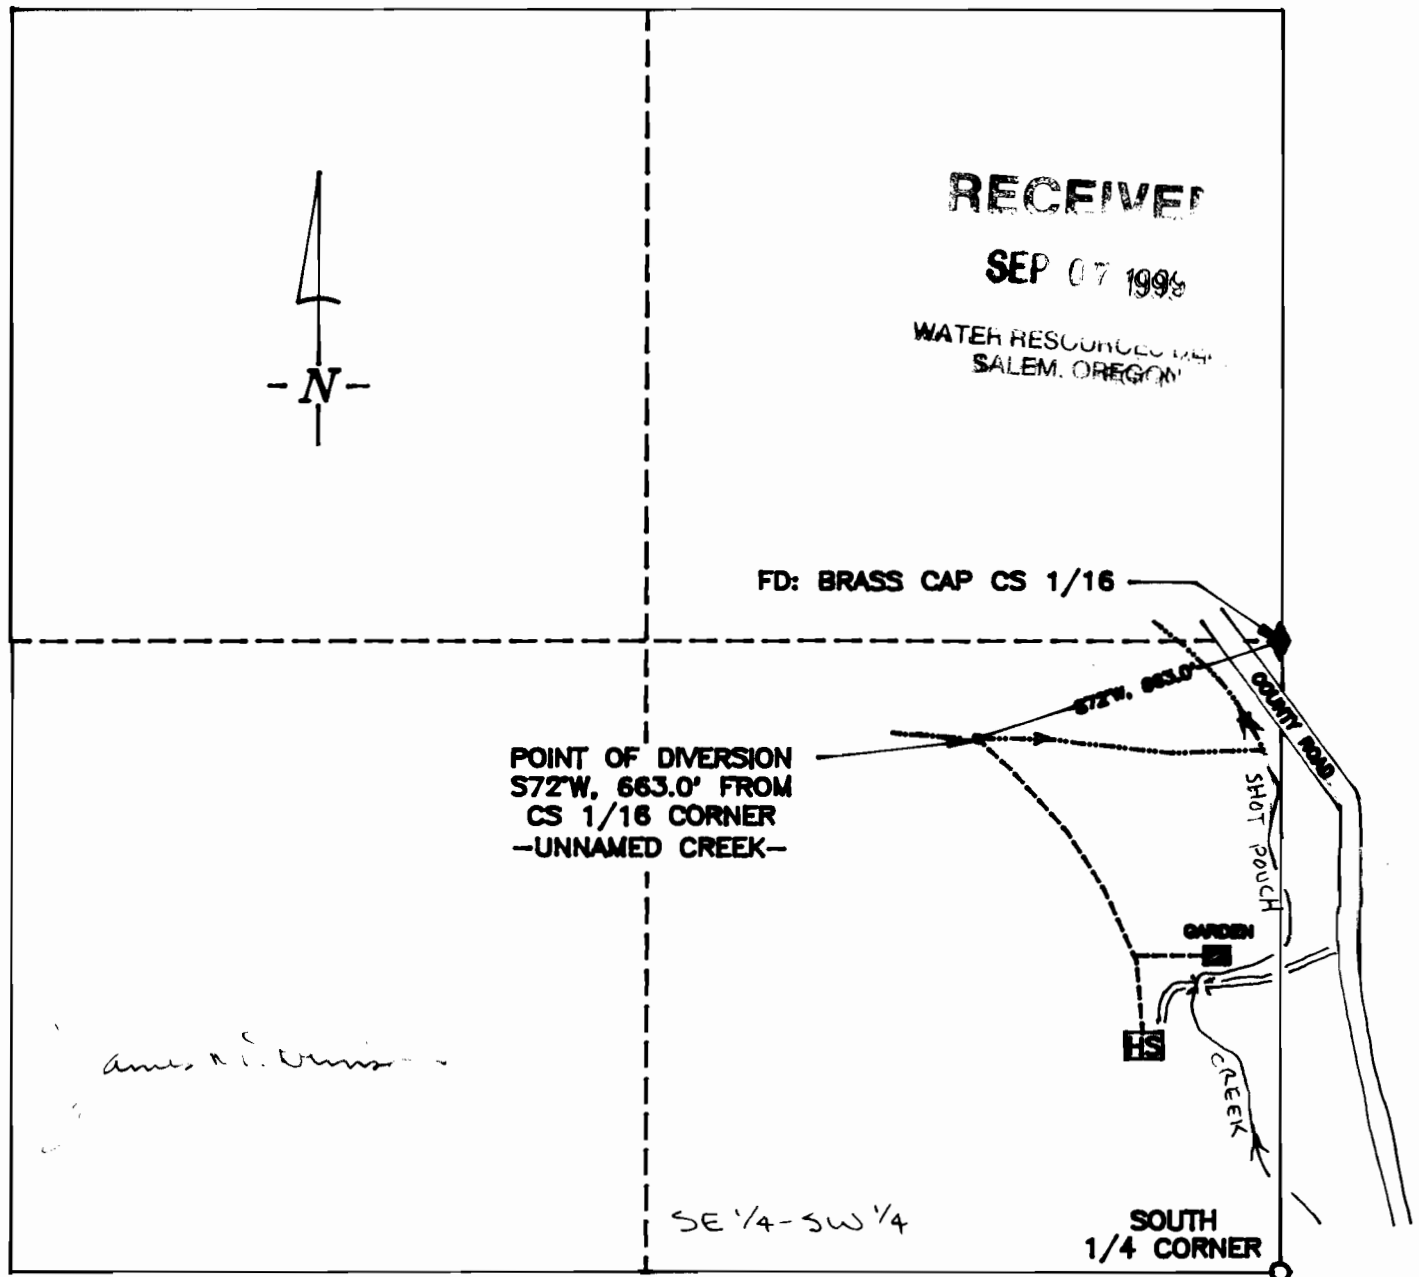

**FINAL PROOF SURVEY UNDER**

APPLICATION # S-81588

PERMIT # 53507

IN THE NAME OF  
**FRANZ DOLP**

SURVEYED: JULY 14, 1999

BY: J. M. DENISON

THIS MAP PREPARED SOLEY FOR THE PURPOSE OF SHOWING LOCATION OF A WATER RIGHT, AND IS NOT INTENDED FOR USE TO PROVIDE DIMENSIONS OR LOCATION OF PROPERTY OWNERSHIP LINES