


T. 5 S., R. 10 W., W.M.

SECTION 17

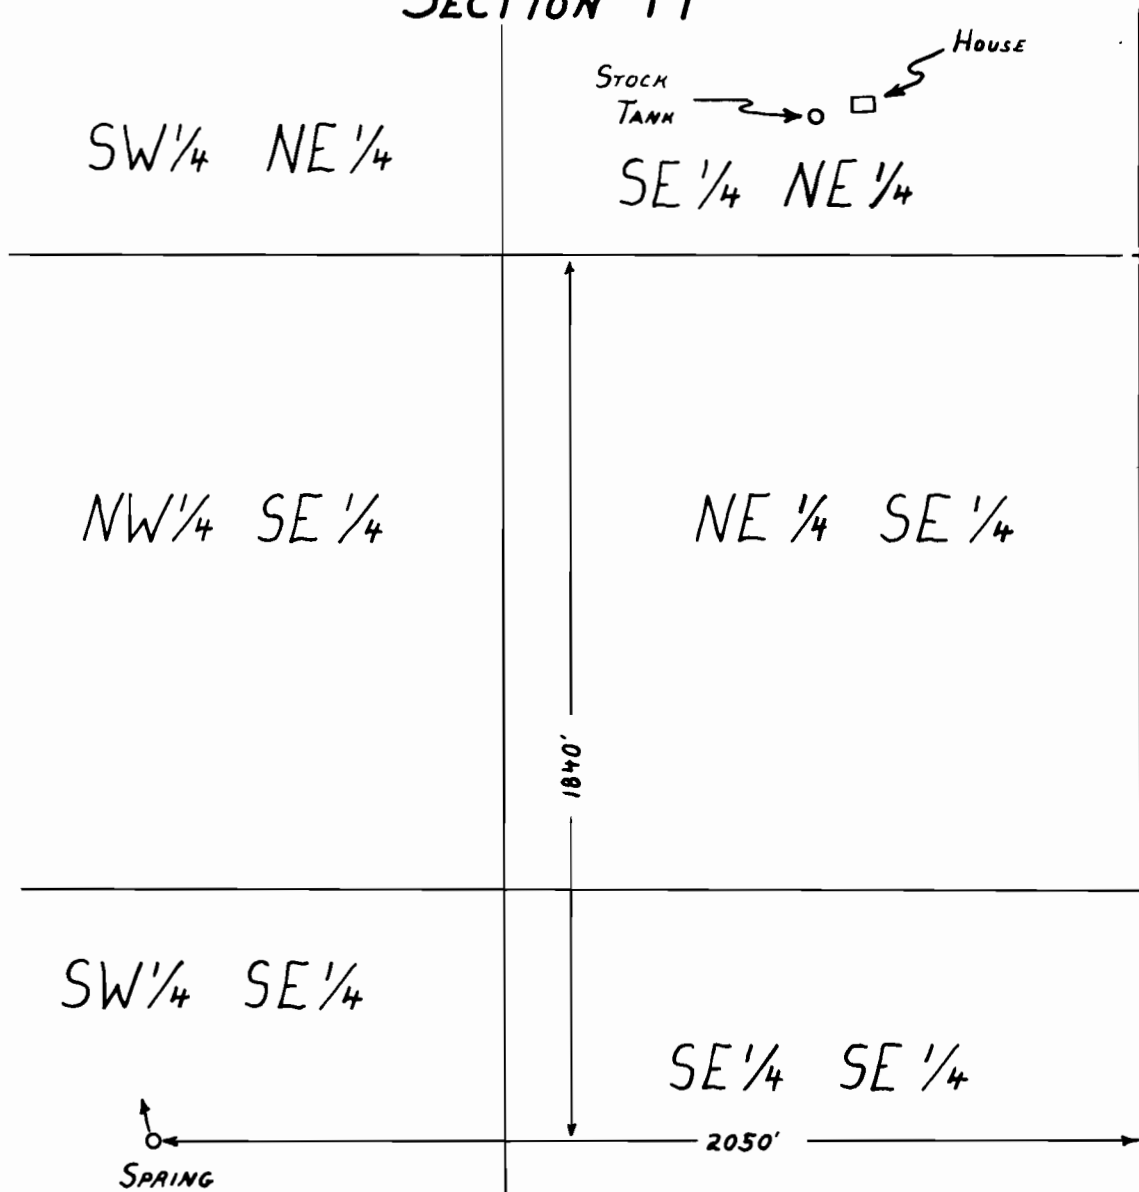

FINAL PROOF SURVEY

UNDER

Application No. 55738 Permit No. 41746
IN NAME OF

ELIZABETH SUMBS

Surveyed SEPTEMBER 24, 1991, by R.W. Klassen