


T.40S.,R.1E.,W.M.

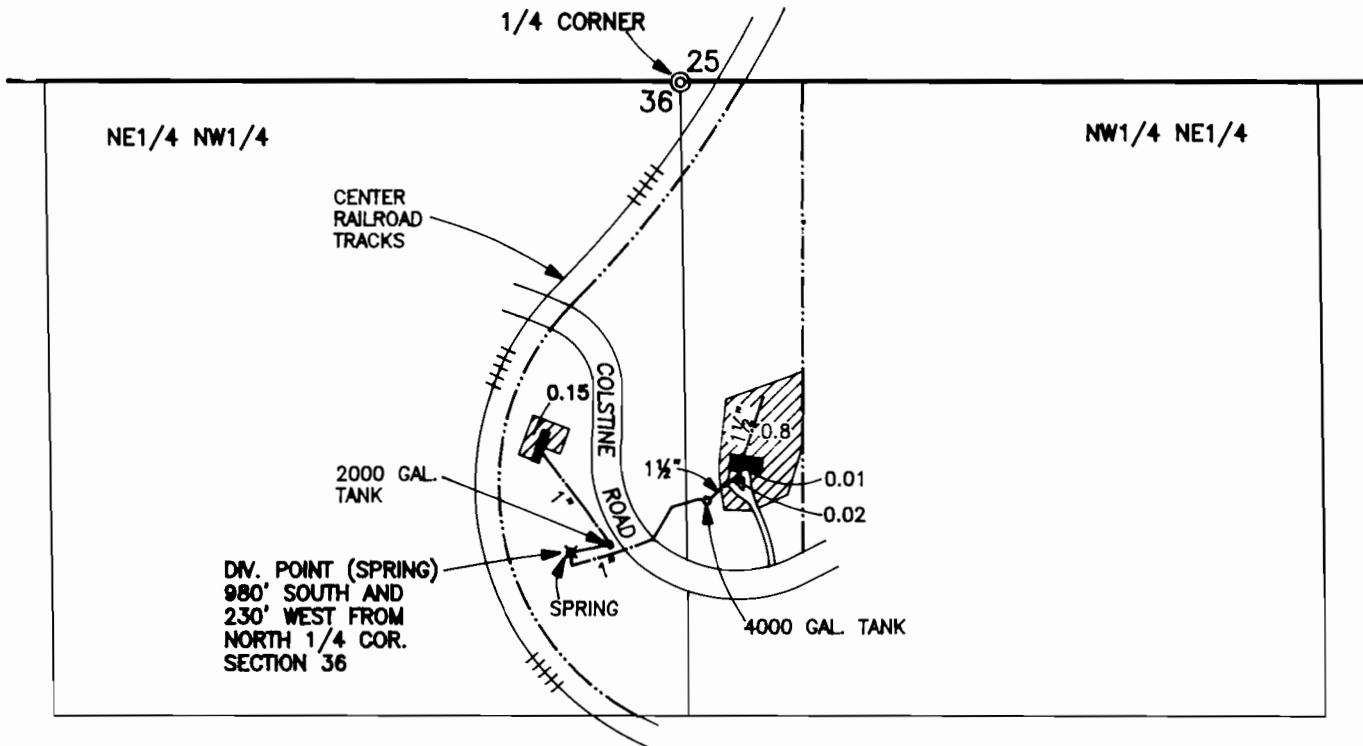

SCALE 1" = 400'




NOTE: MAP PREPARED FOR
WATER RIGHT PURPOSES ONLY,
NOT FOR PROPERTY BOUNDARY
LOCATIONS.

FINAL PROOF MAP

APPLICATION No. S-71947
PERMIT No. 52769

IN THE NAME OF
LAURENCE D. & FLORA BISHOP
AND
JANEEN & CHRISTOPHER TAYLOR

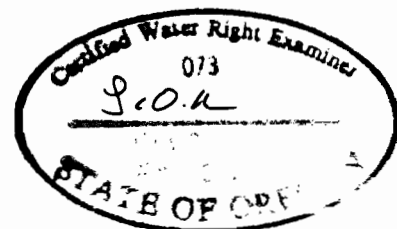

MAP PREPARED SEPTEMBER 13, 2000 BY GARY D. KAISER

RECEIVED

SEP 27 2000

WATER RESOURCES DEPT.
SALEM, OREGON