

FINAL PROOF SURVEY

APPLICATION No. S-72283
APPLICATION No. R-80583

PERMIT No. 53066
PERMIT No. R-1213

RECEIVED

Applicant: Marjorie Sykes
1928 Big Bend Road
Adrian, OR 97901

OCT 25 1999
WATER RESOURCES DEPT.
SALEM, OREGON

Scale 1"=400'

T21S R46E

C1/4

BIG BEND ROAD



1255N

1/4

S26 S25

S35 S36

MILLER ROAD

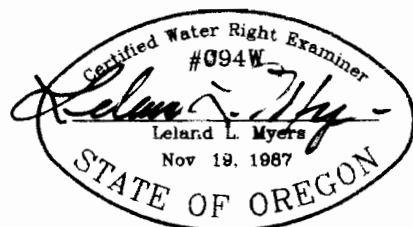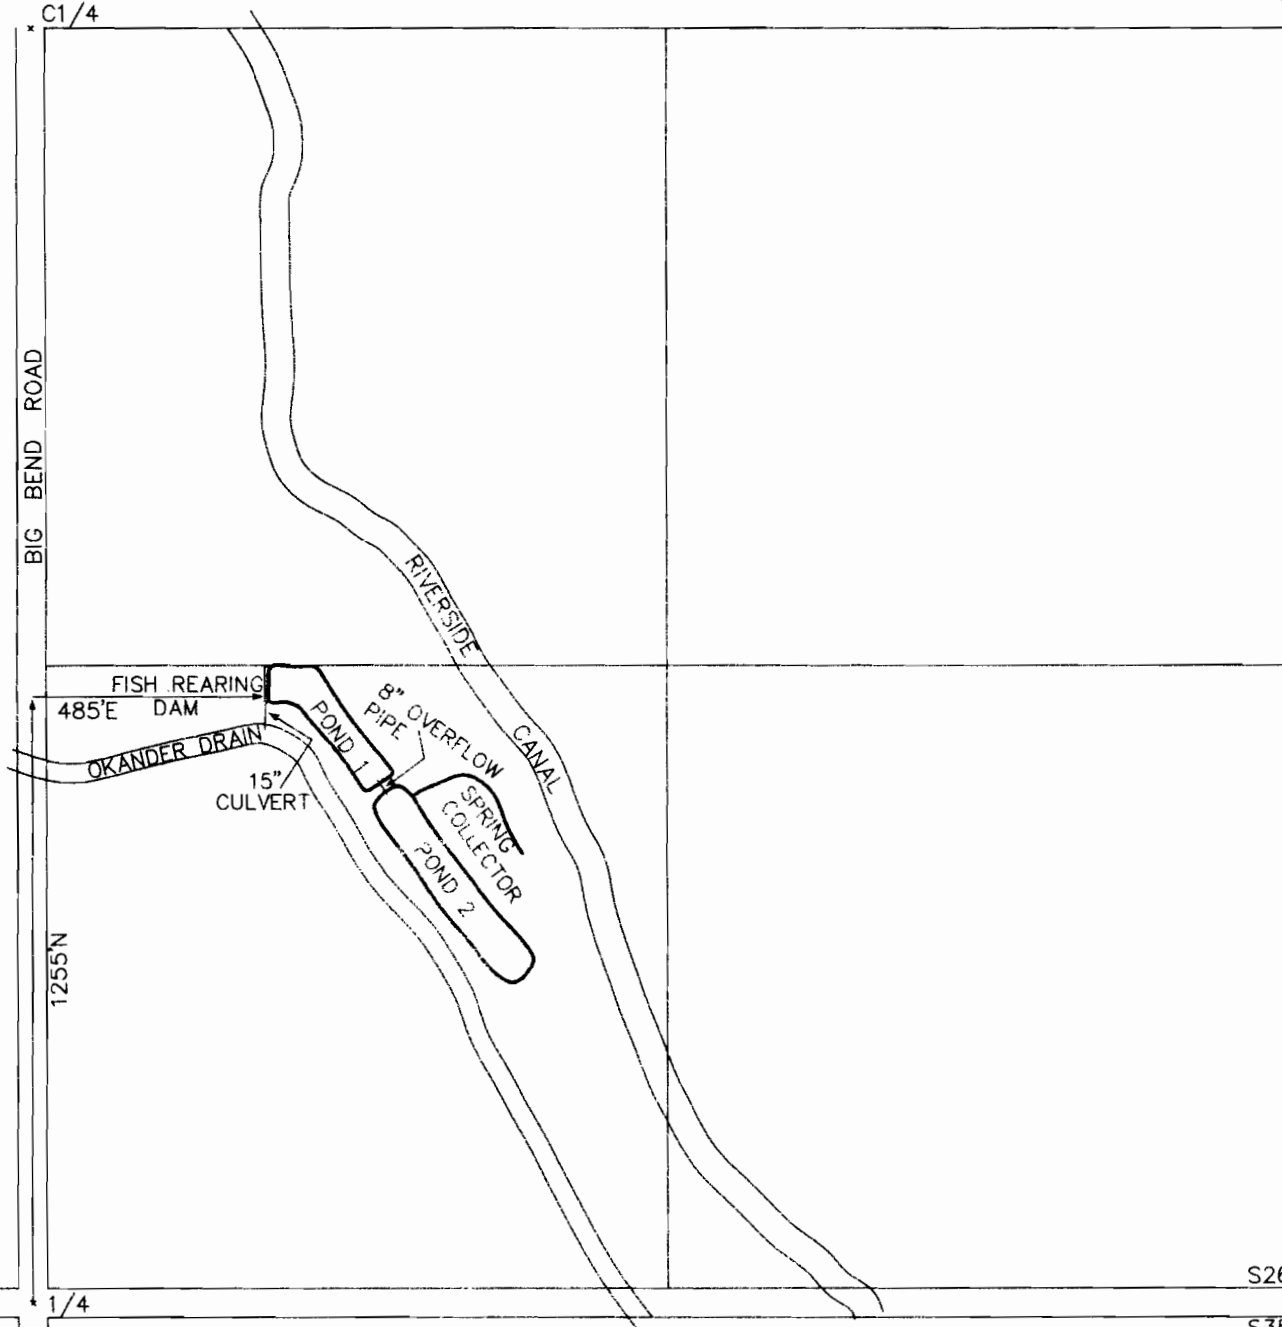

This map is for the purpose of identifying the location of the water right only and has no intent to provide dimensions or location of property ownership lines.