

FINAL PROOF SURVEY

APPLICATION No. S-72283
APPLICATION No. R-80583

PERMIT No. 53066
PERMIT No. R-1213



Applicant: Marjorie Sykes
1928 Big Bend Road
Adrian, OR 97901

RECEIVED

OCT 25 1999
WATER RESOURCES DEPT.
SALEM, OREGON

Scale 1"=400'

T21S R46E

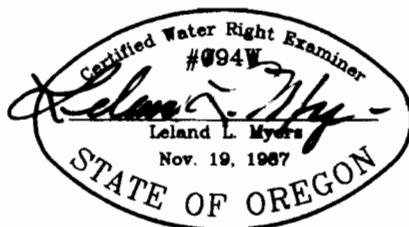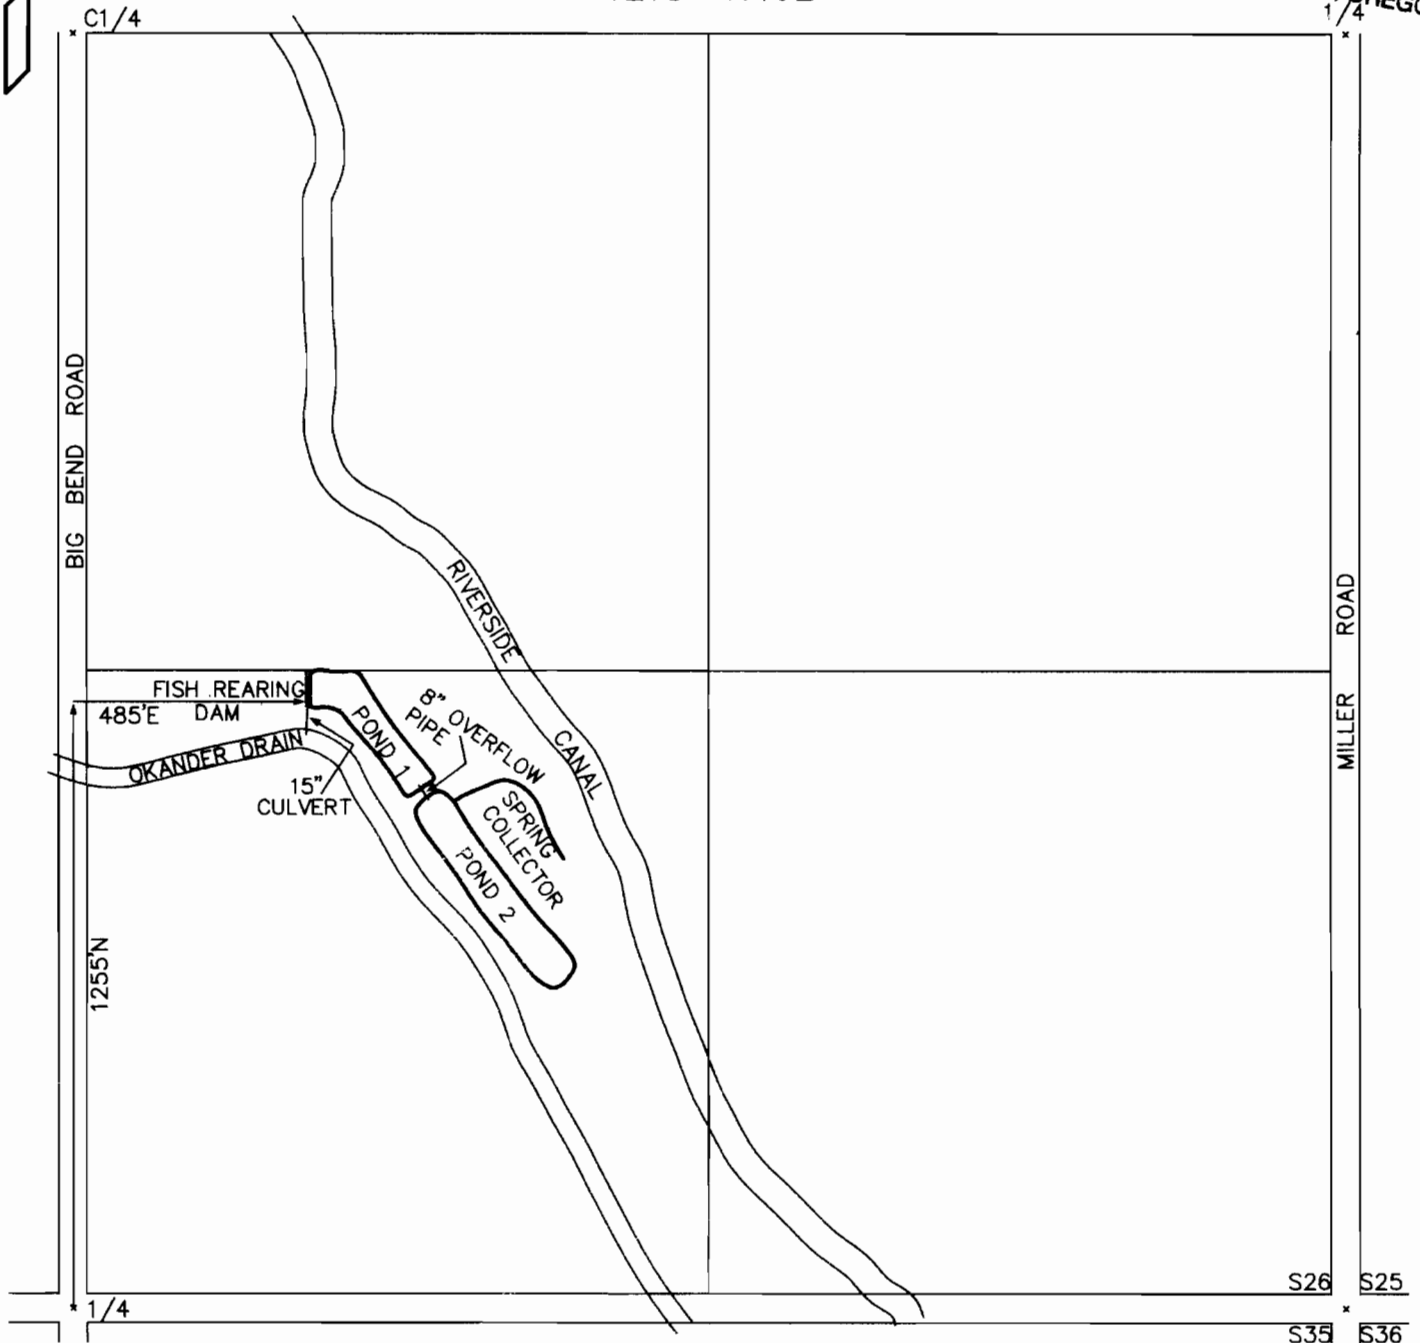

This map is for the purpose of identifying the location of the water right only and has no intent to provide dimensions or location of property ownership lines.