

T11S, R11W, W.M.
SW 1/4 - NE 1/4 SECTION 10
LINCOLN COUNTY, OREGON



SCALE 1 inch = 400 feet



RECEIVED

JAN 26 1998

WATER RESOURCES DEPT
SALEM, OREGON

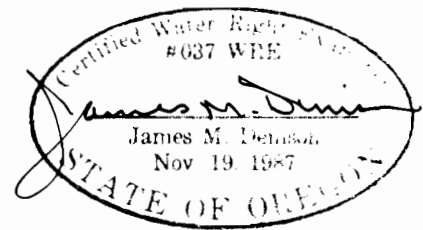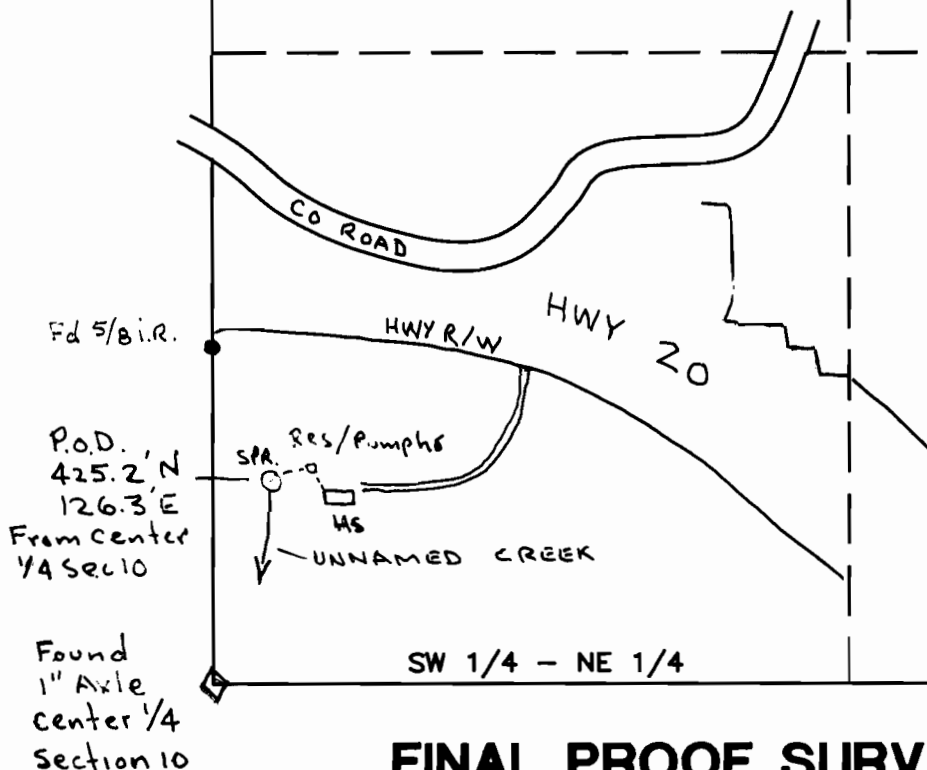

FINAL PROOF SURVEY UNDER

APPLICATION • S-73743

PERMIT • 51655

**IN THE NAME OF
DOUGLAS and LINDA ROBERTS**

SURVEYED: SEPTEMBER 10, 1997

BY: J. M. DENISON

THIS MAP PREPARED SOLEY FOR THE PURPOSE OF SHOWING LOCATION OF A WATER RIGHT, AND IS NOT INTENDED FOR USE TO PROVIDE DIMENSIONS OR LOCATION OF PROPERTY OWNERSHIP LINES