


FINAL PROOF SURVEY & BENEFICIAL USE MAP

Place of use is located in portions of the NW¼ NW¼; SW¼ NW¼; SE¼ NW¼;
SW¼ SE¼ Section 25, SW¼ NE¼ and the SE¼ NE¼ of Section 26
Township 33 South, Range 15 West, Willamette Meridian

Curry County, Oregon


Application #S-76182 Permit #53236

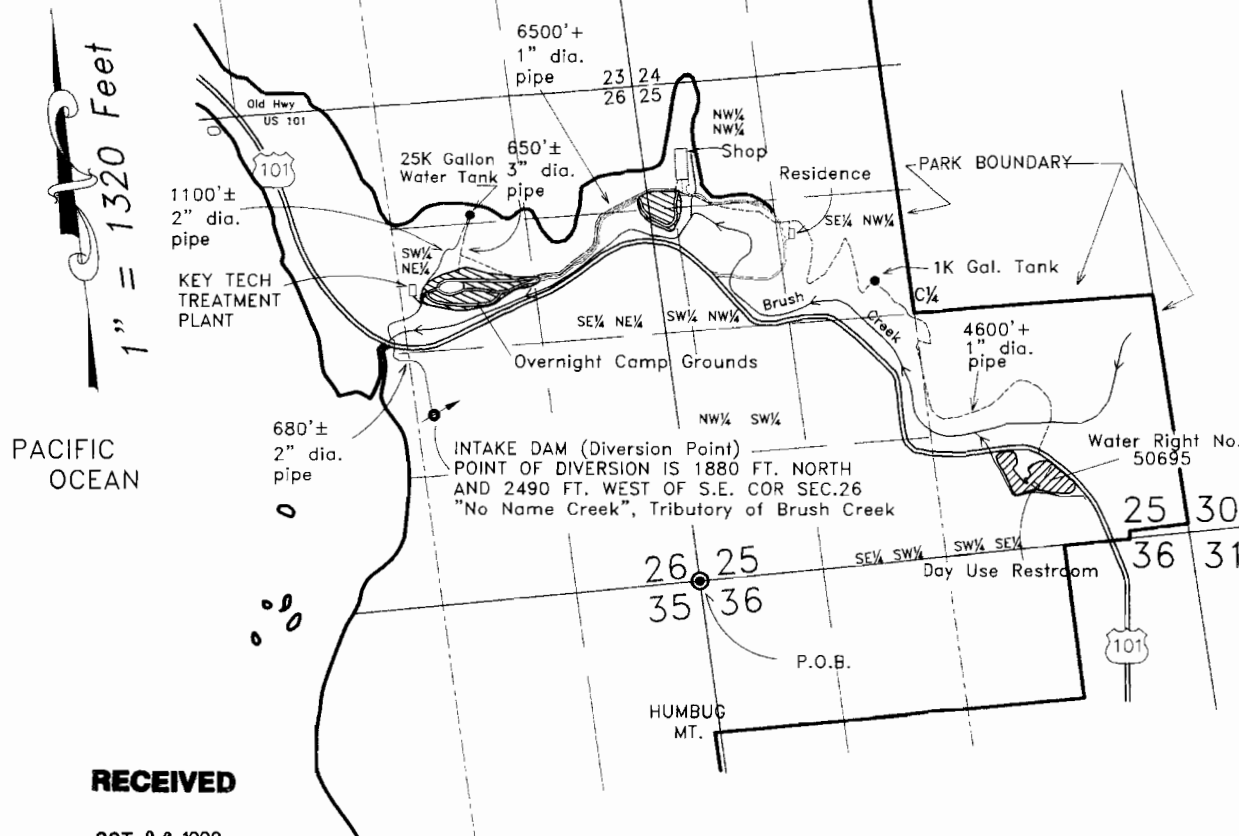

Prepared For: Oregon Parks and Recreation Department
C/O Jim Roethlin
Salem, Oregon
Prepared By: Dennis Goude
Surveyed: September 21, 1998

NOTE:
The P.O.D. is a concrete dam measuring four feet high, seven feet long and six inches thick, built in gravel filter.

LEGEND
P.O.B.
P.O.D.
DAY USE
OVERNIGHT
PIPE

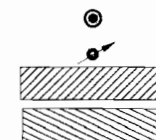

Exp. 06/30/99

RECEIVED

OCT 06 1998

WATER RESOURCES DEPT.
SALEM, OREGON

EXAMINERS DISCLAIMER STATEMENT

The preparation of this map was for the purpose of identifying the location of the Water Right only and has no intent to provide dimensions or location of property ownership lines.

Stuntzner Engineering

& Forestry, LLC

ENGINEERING • LAND SURVEYING • FORESTRY
PLANNING • WATER RIGHTS

705 South 4th St.
Post Office Box 118
Coos Bay, Oregon 97420

Phone (541) 267-287
Fax (541) 267-0588