



FINAL PROOF SURVEY
SECTION 4
TOWNSHIP 39 SOUTH, RANGE 2 EAST
WILLAMETTE MERIDIAN, JACKSON COUNTY, OREGON

For
James C. Miller, Miller Ranch; Black Rock Land and Gravel Inc.
P.O. Box 1088
Ashland, Oregon 97520

Section 4
Township 39 South, Range 2 East
Application S-84551, Permit 53924

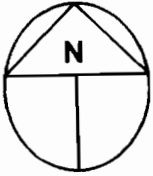

Scale 1" = 1320'
September 3, 2003

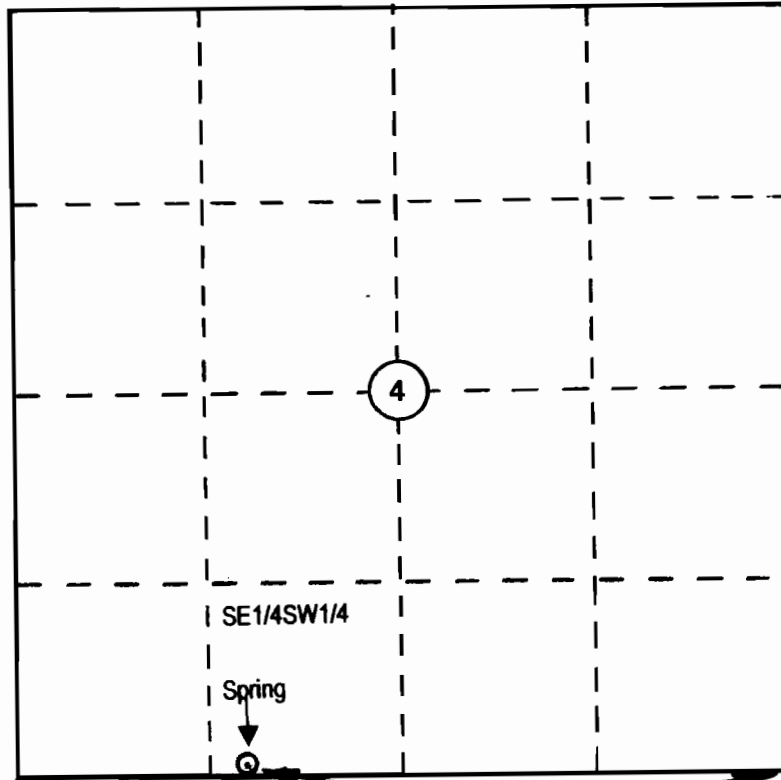

Spring and Water Trough are situated North 50 feet and West 3665 feet from the Southeast corner of Section 4, T39S, R2E.

Certified Water Right Examiner
HAROLD L. CENTER, P.L.S., C.W.R.E.
Certified Water Right Examiner
Oregon Certificate No. 152
2604 David Lane
Medford, OR. 97504
541-535-6108



RECEIVED
SEP 15 2003
WATER RESOURCES DEPT.
SALEM, OREGON

This map was prepared for the purpose of identifying the location of a water right only and is not intended to provide legal dimensions or locations of property ownership lines.