


T.4S., R.1W., W.M.

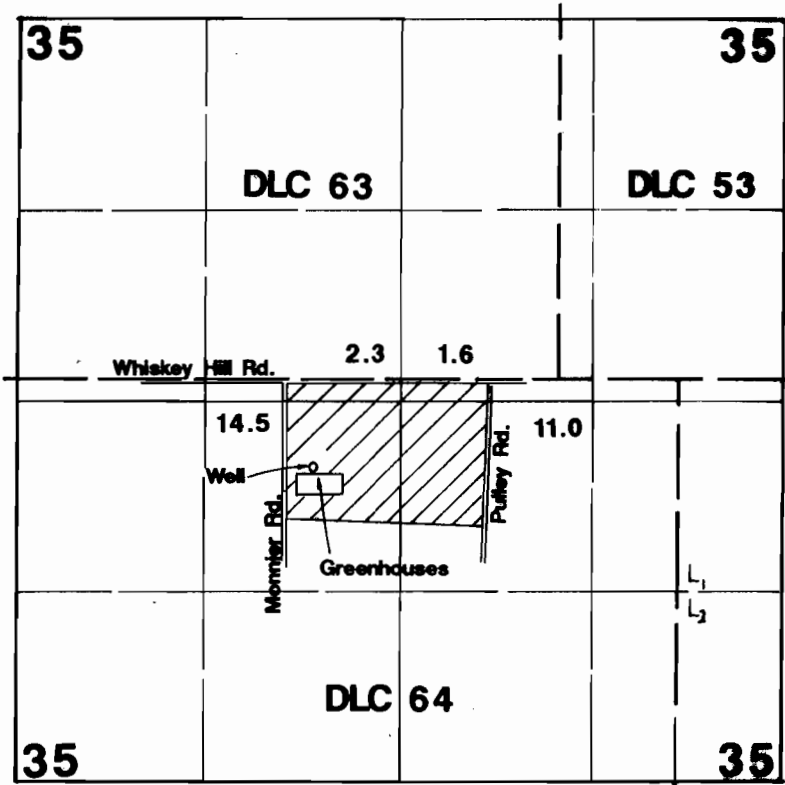

Well located 615'S & 2490'W from NE corner DLC 64.

Final Proof Survey

Application #: G-12729 Permit #: G-11898 **RECEIVED**


In Name Of

OCT 18 1996

Dieringer Nursery

WATER RESOURCES DEPT.
SALEM, OREGON

Surveyed on September 28, 1996 by JM Schuette

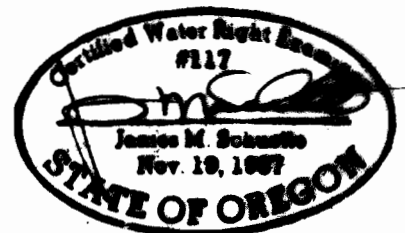

THIS MAP WAS PREPARED FOR THE PURPOSE OF IDENTIFYING THE LOCATION OF A WATER RIGHT ONLY AND IS NOT INTENDED TO PROVIDE LEGAL DIMENSIONS OR LOCATION OF PROPERTY OWNERSHIP LINES.