


Joan Howard

5N R. 36E, W.M.
Section 31

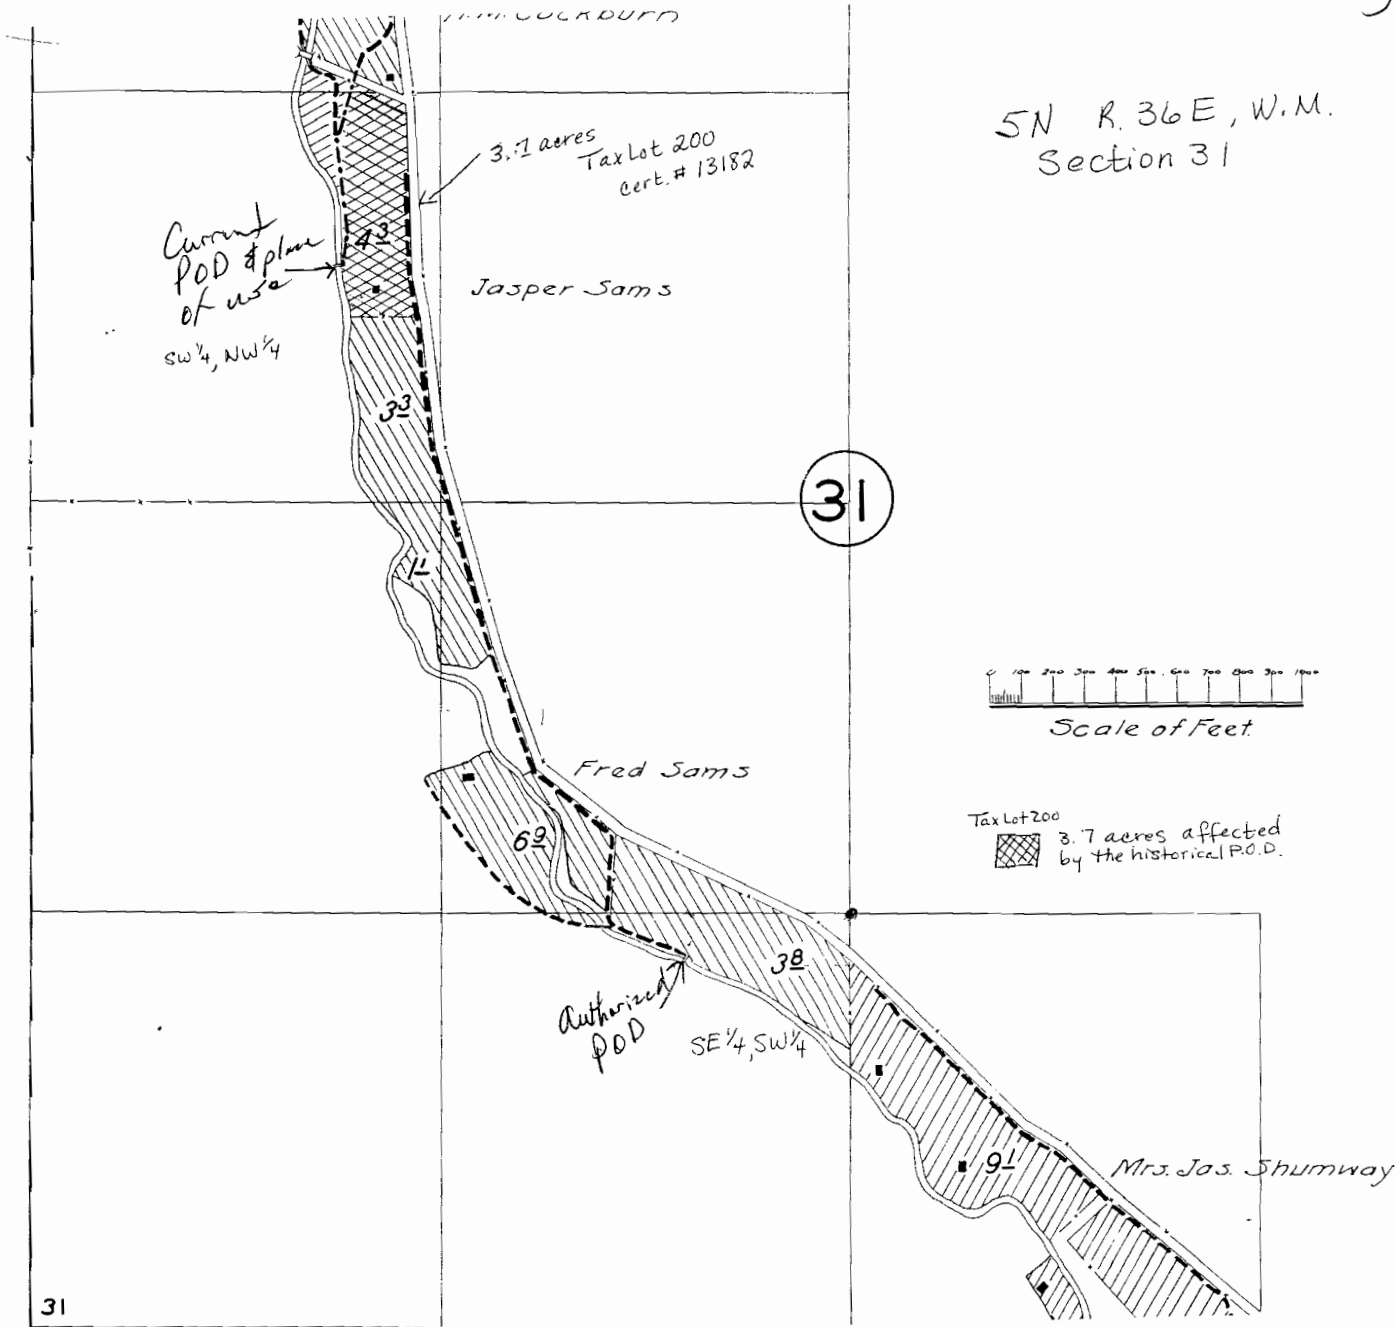

RECEIVED
 JUN 25 2007
 WATER RESOURCES DEPT
 SALEM OREGON

104.3

31

Attachment 1