


T. 40S., R. 13W., W.M.

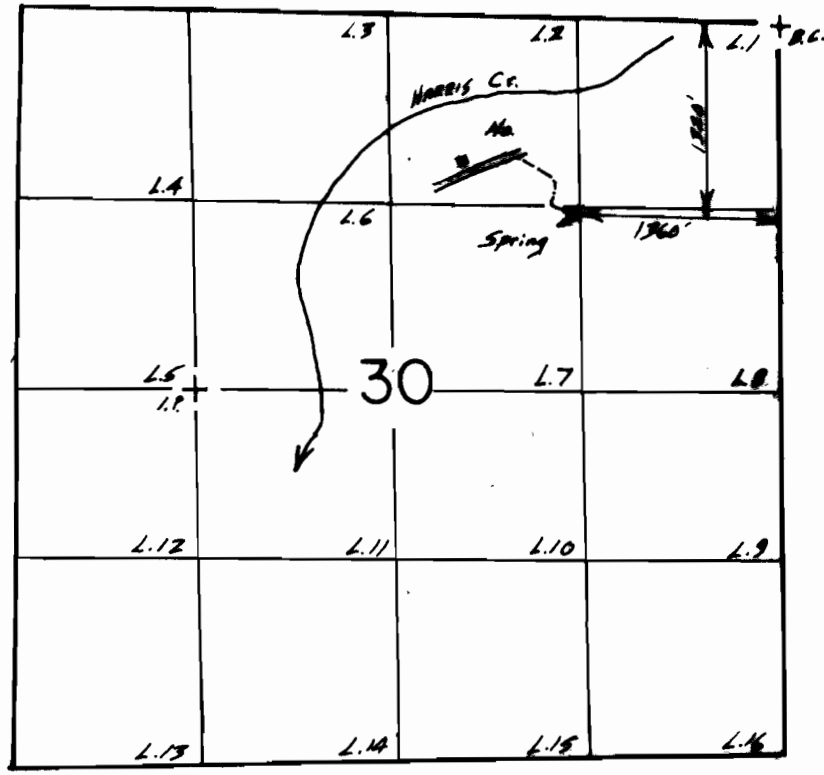

Scale 1" = 1320'

**FINAL PROOF SURVEY
UNDER**

Application No. 47181 Permit No. 35321
IN NAME OF

Carl & Glenda Decker

Surveyed April 7, 1997, by B.S. DeHaas.....

RECEIVED

JUL 22 1998

WATER RESOURCES DEPT.
SALEM, OREGON