T. 34 S., R. 7 E., W.M.

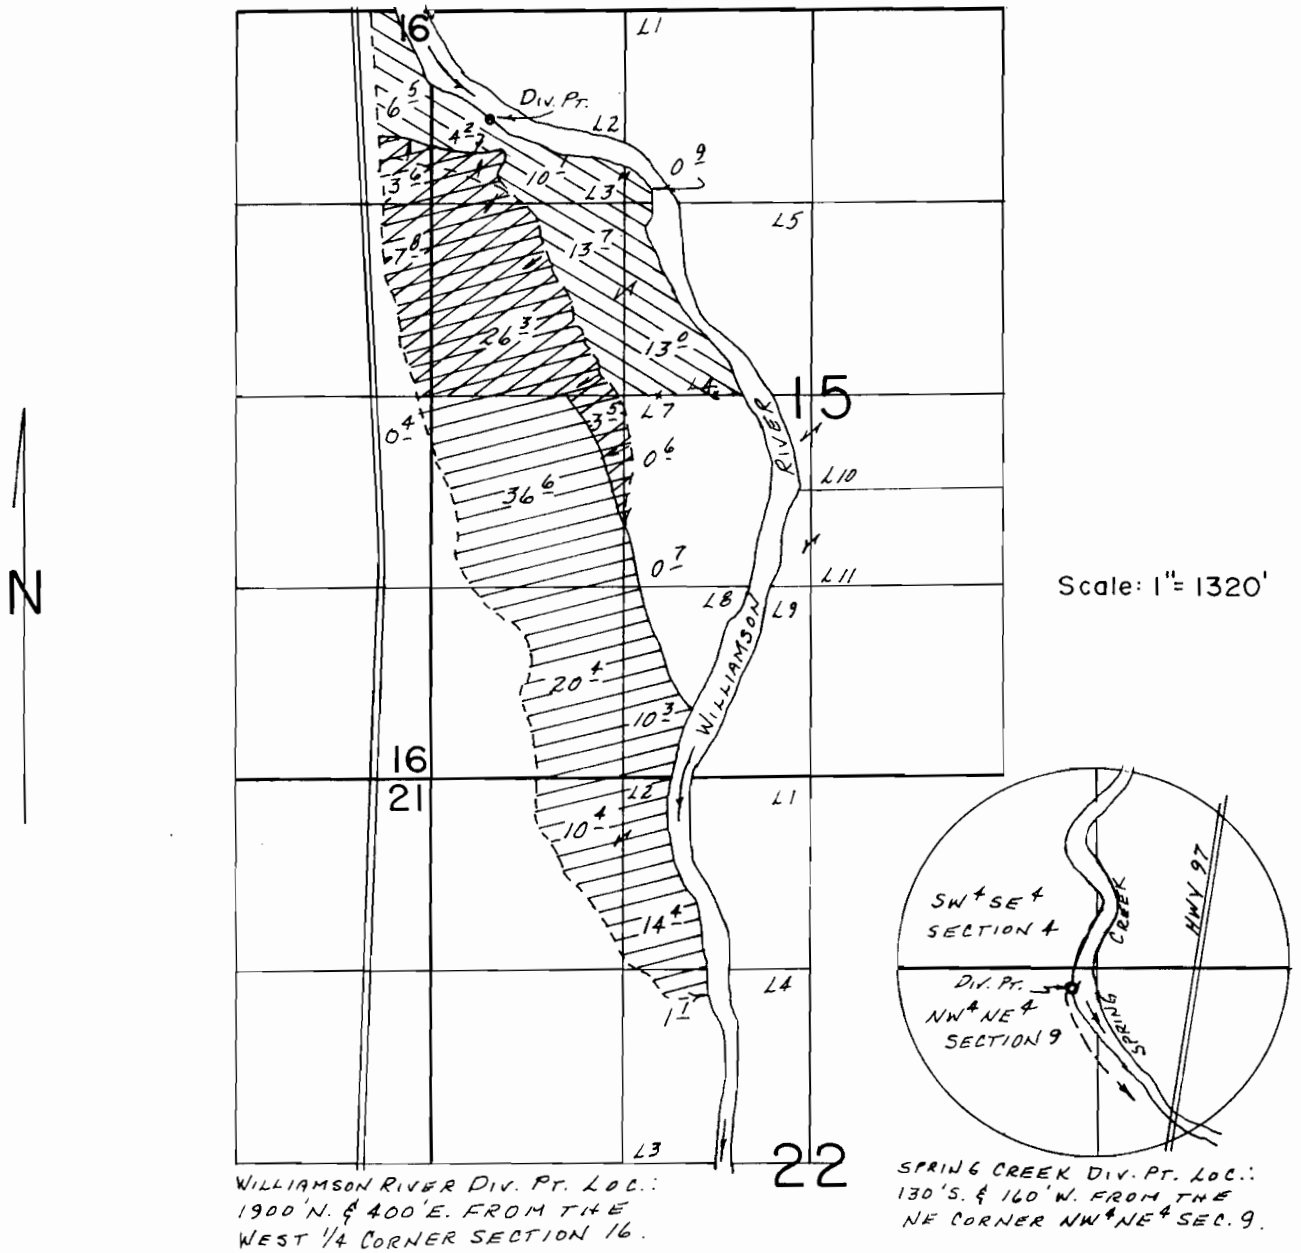

FINAL PROOF SURVEY

UNDER

Application No.	64961	Permit No.	47555	PRIMARY	SUPPLEMENTAL
Application No.	52491	Permit No.	37800		

IN NAME OF

KENNETH L. AND KAREN L. TUTTLE

Surveyed SEPT. 11, 1986, by B.W. BISHOP

WAC 850-R 1870

2-25-92
BWB