


HE 428

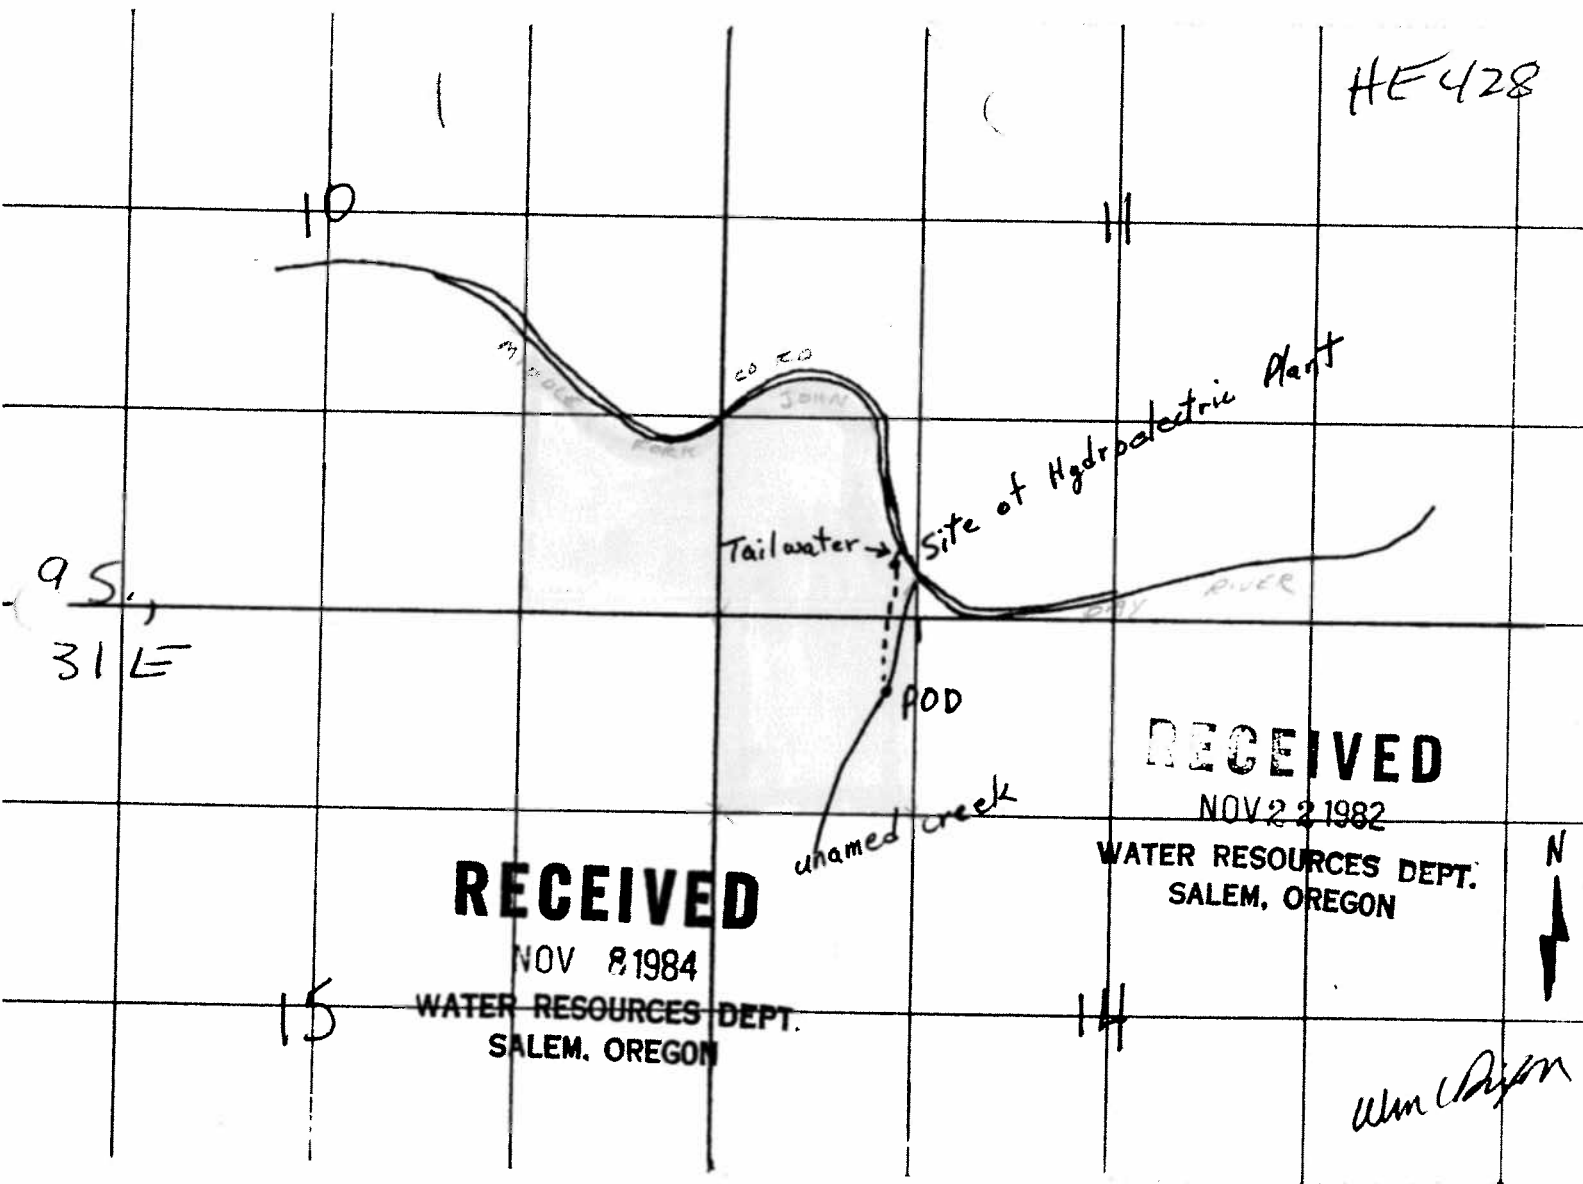

9.5,
31 E

RECEIVED

NOV 8 1984

WATER RESOURCES DEPT.
SALEM, OREGON

RECEIVED

NOV 22 1982

WATER RESOURCES DEPT.
SALEM, OREGON



Wm Dixon

4" = 1 mile

Property ownership