


T. 23S., R 10W., W. M.

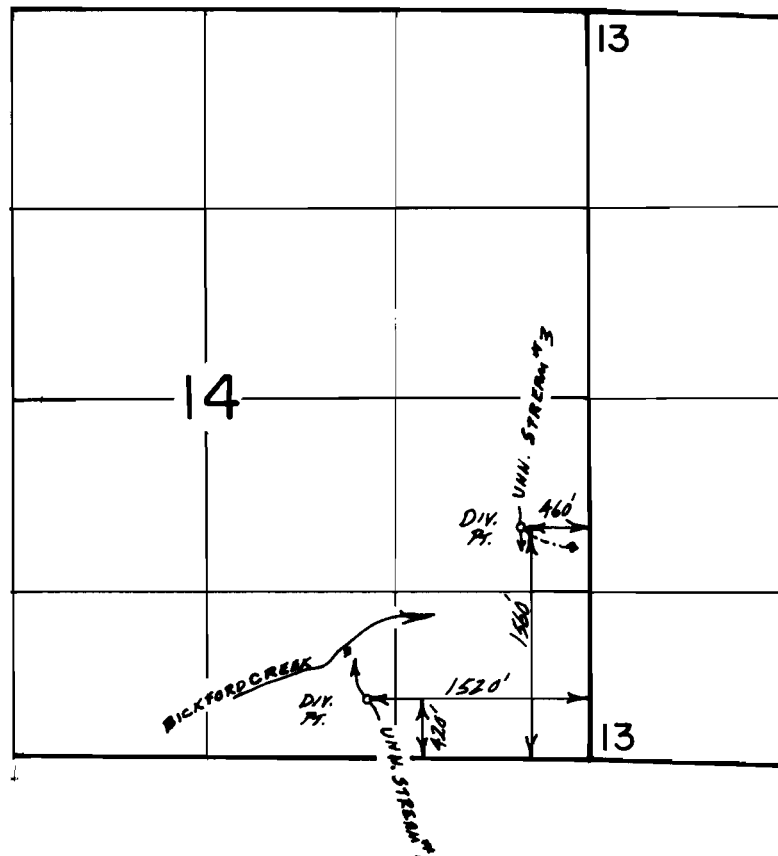

Scale 1" = 1320'

FINAL PROOF SURVEY **UNDER**

Application No. 61787. Permit No. 46040...
IN NAME OF

NANETTE M. DETTLAFF.....

Surveyed April 12, 1996, by S. DeHAAS.....