


T4N, R4W, W.M.
SECTION 7,
SE 1/4 SE 1/4

RECEIVED

SEP 17 1999

WATER RESOURCES DEPT.
SALEM, OREGON

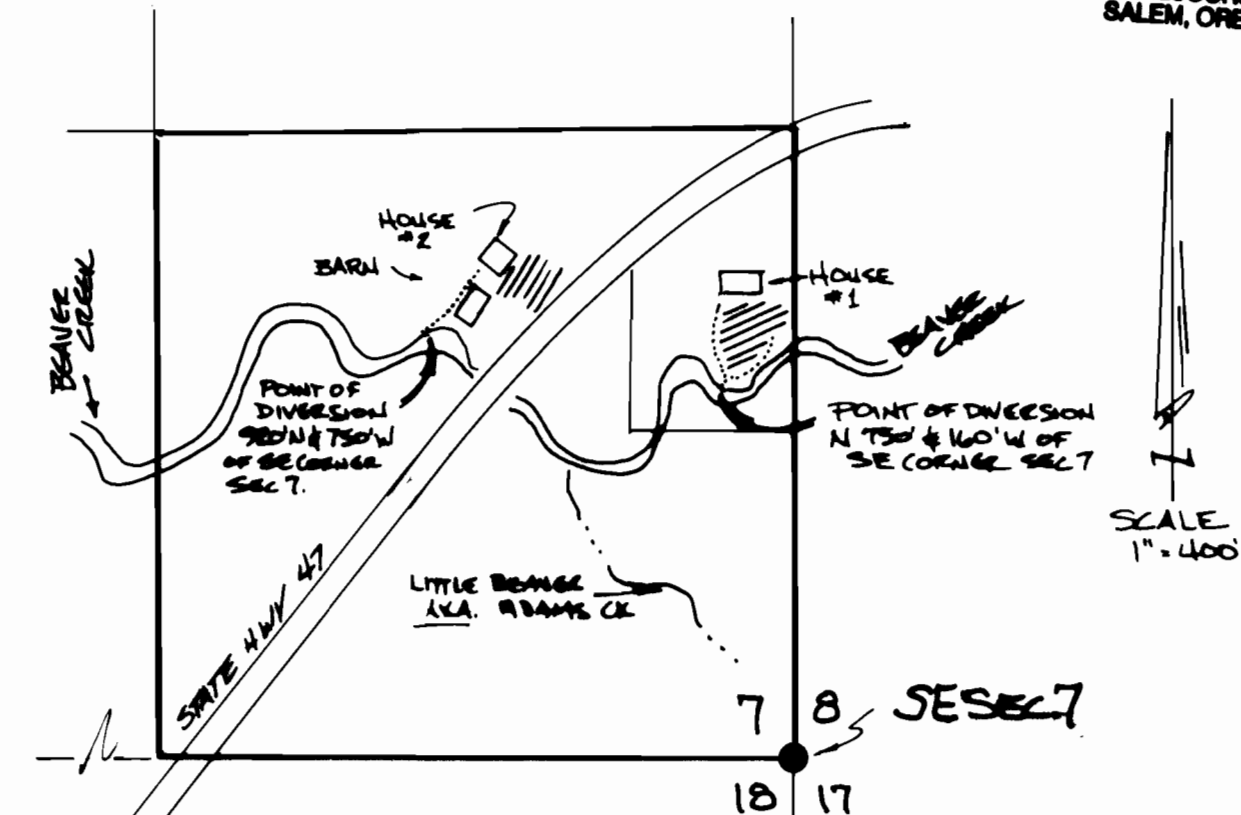

FINAL PROOF SURVEY
under

APPLICATION #: S-74319
PERMIT #: 53307

for; STEVE & SUE MINGER
58195 ADAMS ROAD
VERNONIA, ORE.
97064

SURVEY; AUG. 18, 1999
by: LESLIE G. KEENON
1224 ALDER ST.
VERNONIA, ORE. 97064

