

# SECTION 21, T.3 S., R.3 W., W.M.

YAMHILL COUNTY, OREGON

**RECEIVED**

MAY 11 2000

WATER RESOURCES DEPT.  
SALEM, OREGON





SCALE: 1"=400'

MAP BASE:

ASSESSORS MAP  
CERTIFICATE MAP 61830  
7-98 SCALED PHOTO

PREPARATION OF THIS MAP IS FOR THE  
PURPOSE OF IDENTIFYING THE LOCATION OF  
THE WATER RIGHT ONLY. THERE IS NO INTENT  
TO PROVIDE DIMENSIONS OR LOCATION OF  
PROPERTY OWNERSHIP LINES.

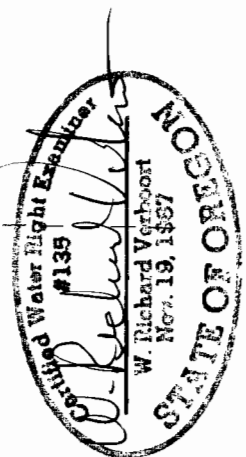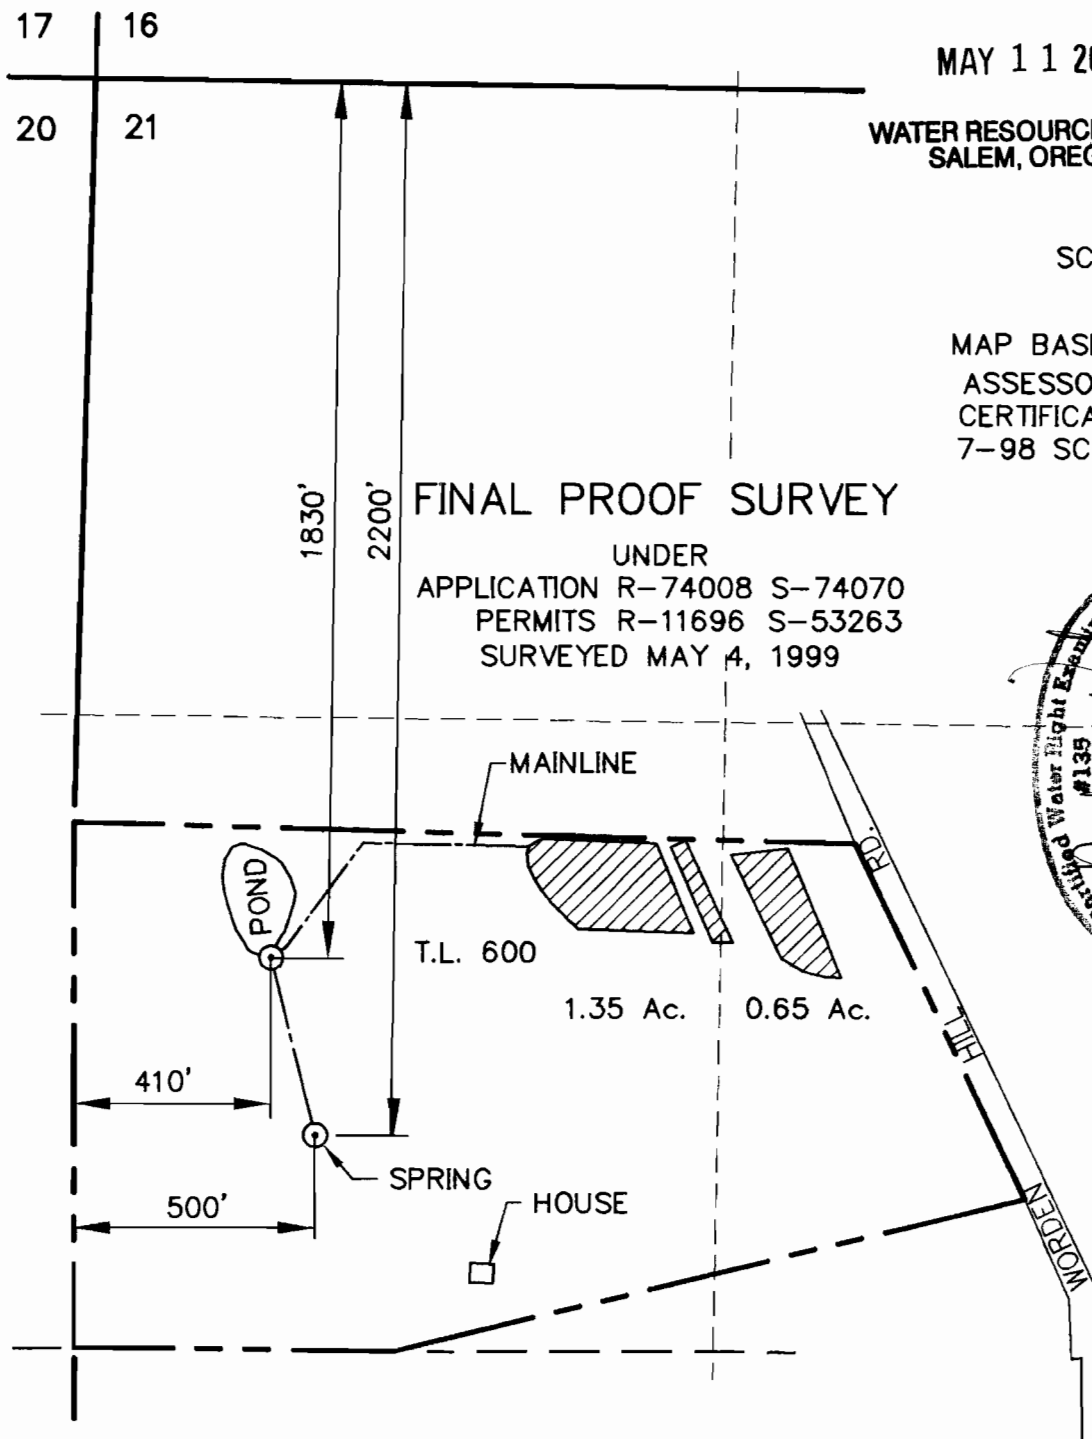

**VERBOORT ENGINEERING**

AGRICULTURE · CIVIL · WATER RESOURCES  
HILLSBORO, OREGON

|             | by      | date |
|-------------|---------|------|
| designed    | WRY     | 4/99 |
| drawn       | JER     | 4/00 |
| checked     | WRY     | 4/00 |
| drawing no. | 00-A-08 |      |
| sheet no.   | 1 / 1   |      |

**DAVID B. WEIL and  
MARY MILLS WEIL**

P.O. BOX 515  
DUNDEE, OR 97115