

SECTION 21, T.3 S., R.3 W., W.M.

YAMHILL COUNTY, OREGON

RECEIVED

MAY 11 2000

WATER RESOURCES DEPT.
SALEM, OREGON




SCALE: 1"=400'

MAP BASE:
ASSESSORS MAP
CERTIFICATE MAP 61830
7-98 SCALED PHOTO

PREPARATION OF THIS MAP IS FOR THE
PURPOSE OF IDENTIFYING THE LOCATION OF
THE WATER RIGHT ONLY. THERE IS NO INTENT
TO PROVIDE DIMENSIONS OR LOCATION OF
PROPERTY OWNERSHIP LINES.

FINAL PROOF SURVEY

UNDER
APPLICATION R-74008 S-74070
PERMITS R-11696 S-53263
SURVEYED MAY 4, 1999

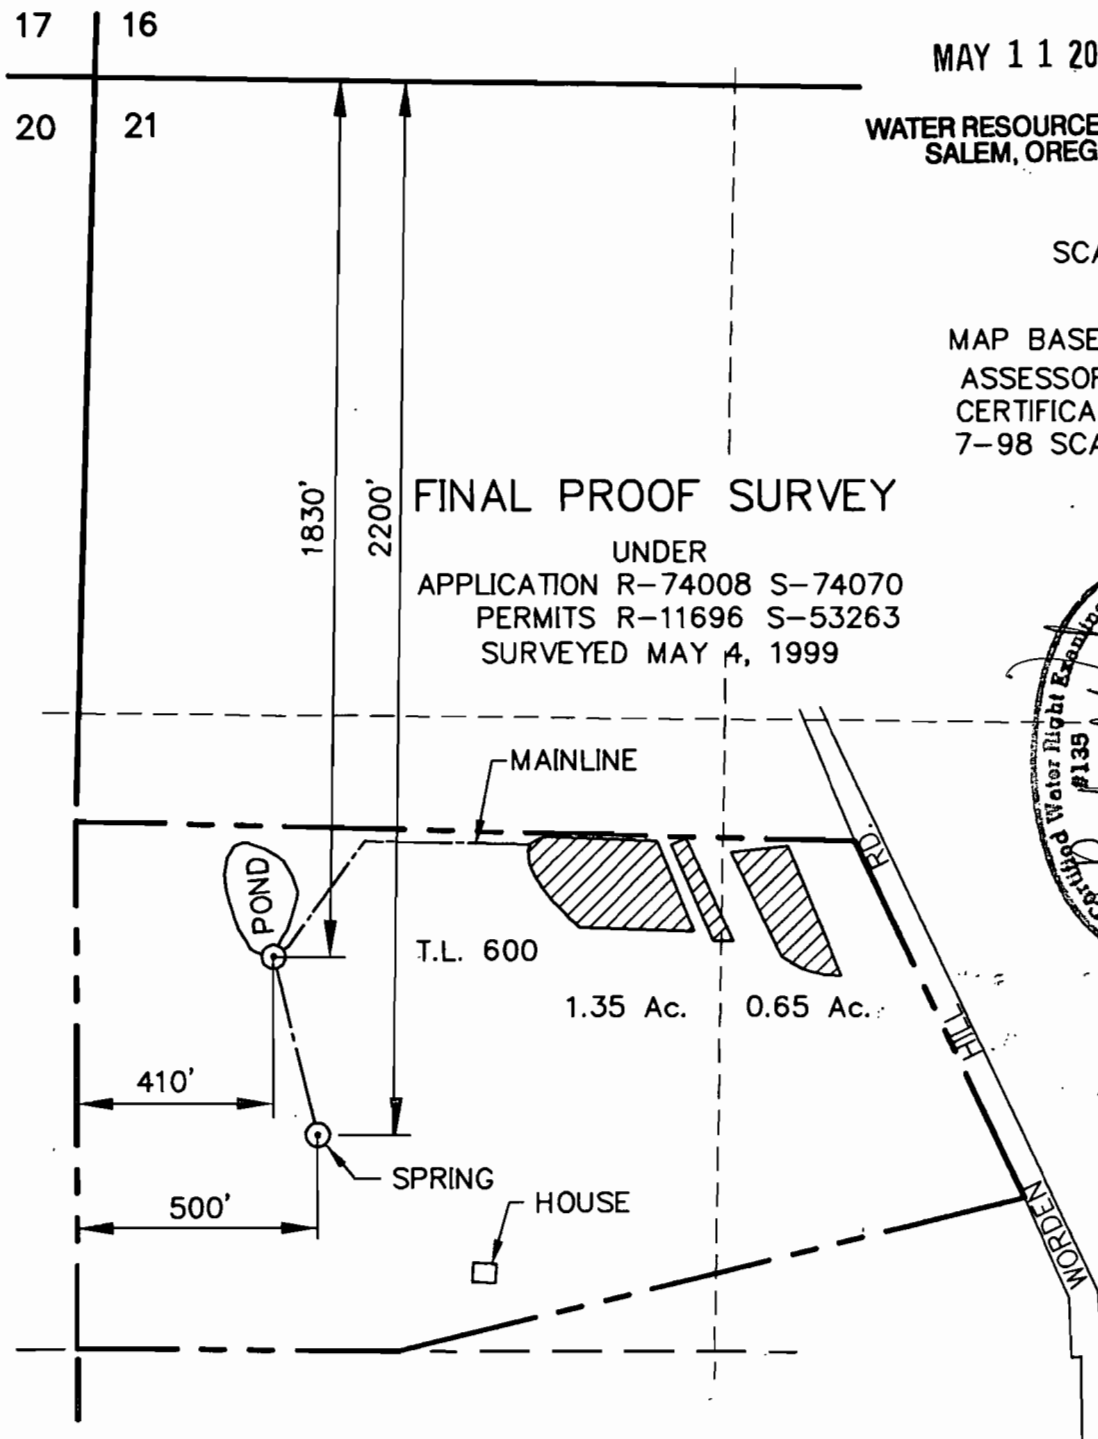

VERBOORT ENGINEERING

AGRICULTURE · CIVIL · WATER RESOURCES
HILLSBORO, OREGON

designed	WRV	4/00
drawn	JER	4/00
checked	WRV	4/00
drawing no.	00-A-06	
sheet no.	1 / 1	

**DAVID B. WEIL and
MARY MILLS WEIL**

P.O. BOX 515
DUNDEE, OR 97115