

RECEIVED

SECTION 21, T.3 S., R.3 W., W.M. SEP 16 1999
YAMHILL COUNTY, OREGON


WATER RESOURCES DEPT.
SALEM, OREGON



SCALE: 1"=400'

MAP BASE:
ASSESSORS MAP
CERTIFICATE MAP 61830


PREPARATION OF THIS MAP IS FOR THE
PURPOSE OF IDENTIFYING THE LOCATION OF
THE WATER RIGHT ONLY. THERE IS NO INTENT
TO PROVIDE DIMENSIONS OR LOCATION OF
PROPERTY OWNERSHIP LINES.

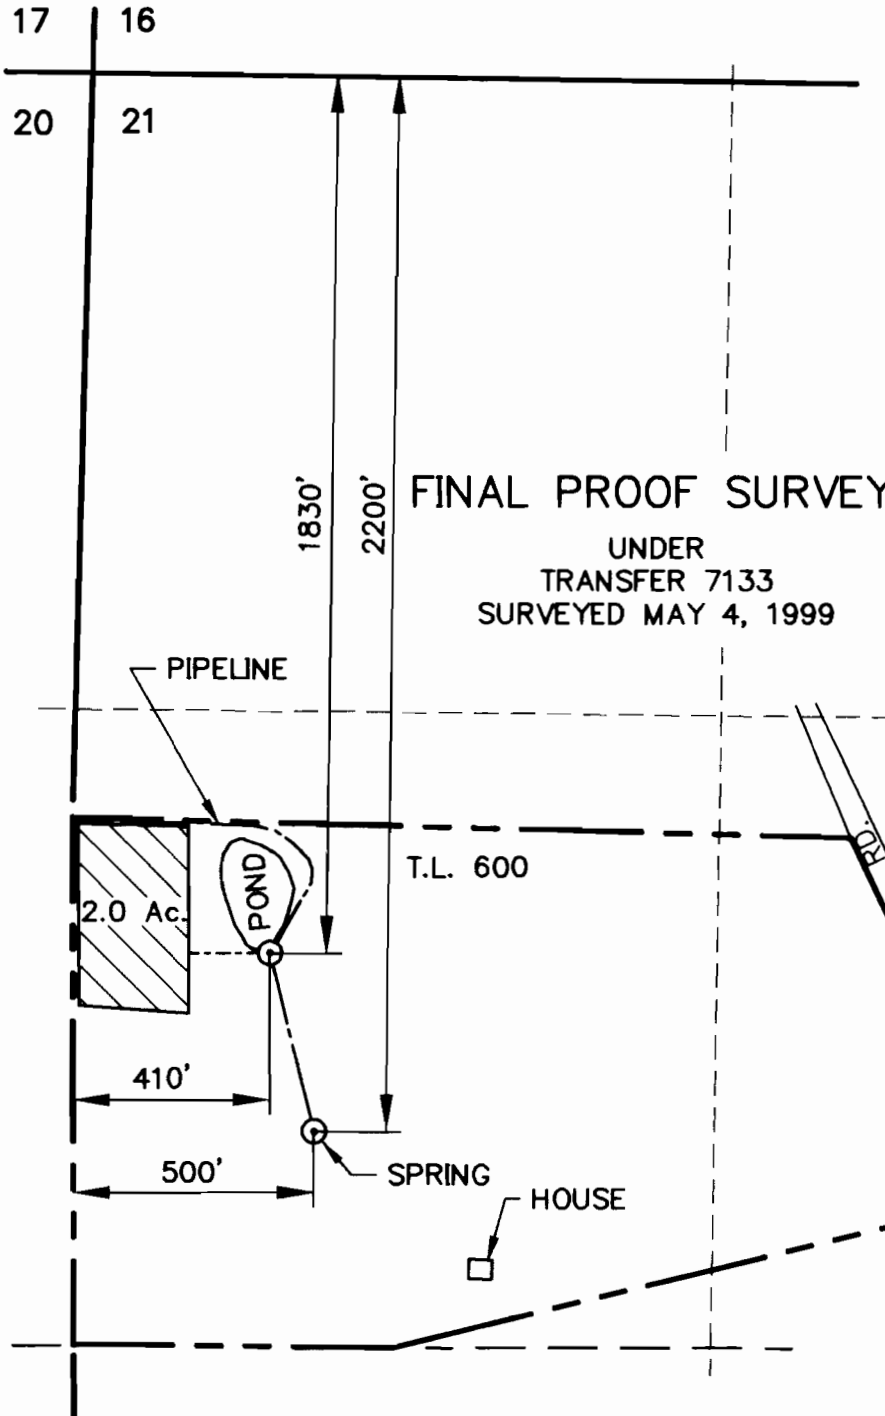

TRANSFER TO

FINAL PROOF SURVEY

UNDER
TRANSFER 7133
SURVEYED MAY 4, 1999

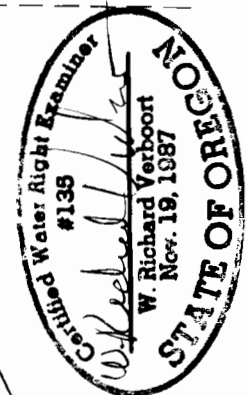

VERBOORT ENGINEERING

AGRICULTURE · CIVIL · WATER RESOURCES
HILLSBORO, OREGON

designed	by	date
drawn	by	date
checked	by	date
drawing no.	sheet no.	

**DAVID B. WEIL and
MARY MILLS WEIL**

P.O. BOX 515
DUNDEE, OR 97115