


T. 37 S., R. 33 E., W.M.

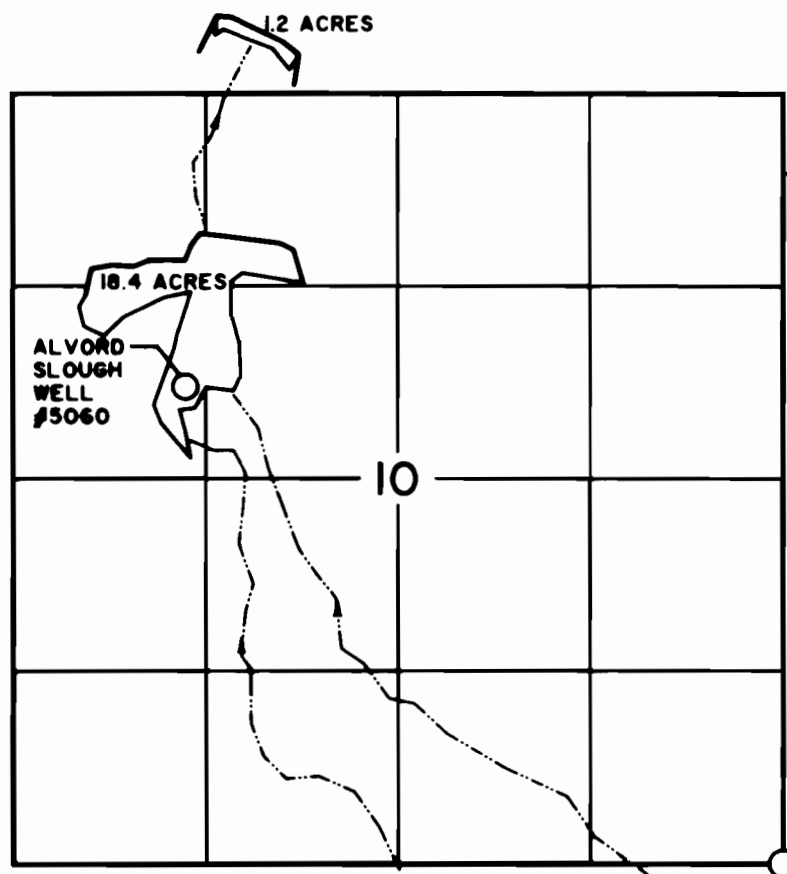

THE WELL IS 3265
FEET NORTH AND
4100 FEET WEST
OF THE SE CORNER
OF SECTION 10.

CLAIM OF BENEFICIAL USE MAP

IN NAME OF

UNITED STATES BUREAU OF LAND MANAGEMENT

APPLICATION NO. G-10633


PERMIT NO. G-10924

RECEIVED

OCT 02 2000

WATER RESOURCES DEPT.
SALEM, OREGON

SURVEYED: MAY 24, 2000

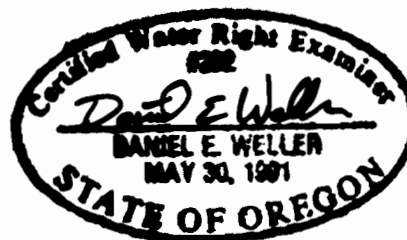

EXPIRES: JUNE 30, 2002

THE PURPOSE OF THIS MAP IS FOR IDENTIFYING THE LOCATION OF THE WATER RIGHT ONLY AND
IS NOT INTENDED TO PROVIDE LEGAL DIMENSIONS OR LOCATION OF PROPERTY OWNERSHIP LINES.

BLM PROJECT NO. OR-5060

U.S. BUREAU OF LAND MANAGEMENT-OSO
BRANCH OF CADASTRAL SURVEY
ALVORD

EXECUTED BY:
DANIEL E. WELLER, PLS, CWRE
P.O. BOX 2965
PORTLAND, OREGON 97208