


RECEIVED

NOV 1 1996

WATER RESOURCES DEPT
STATE OF OREGON

T15S. R11W., W.M.
SE1/4 - SW 1/4 SECTION 2
NE1/4 - NW1/4 SECTION 11
LINCOLN COUNTY, OREGON
Scale: 1 inch = 400 feet

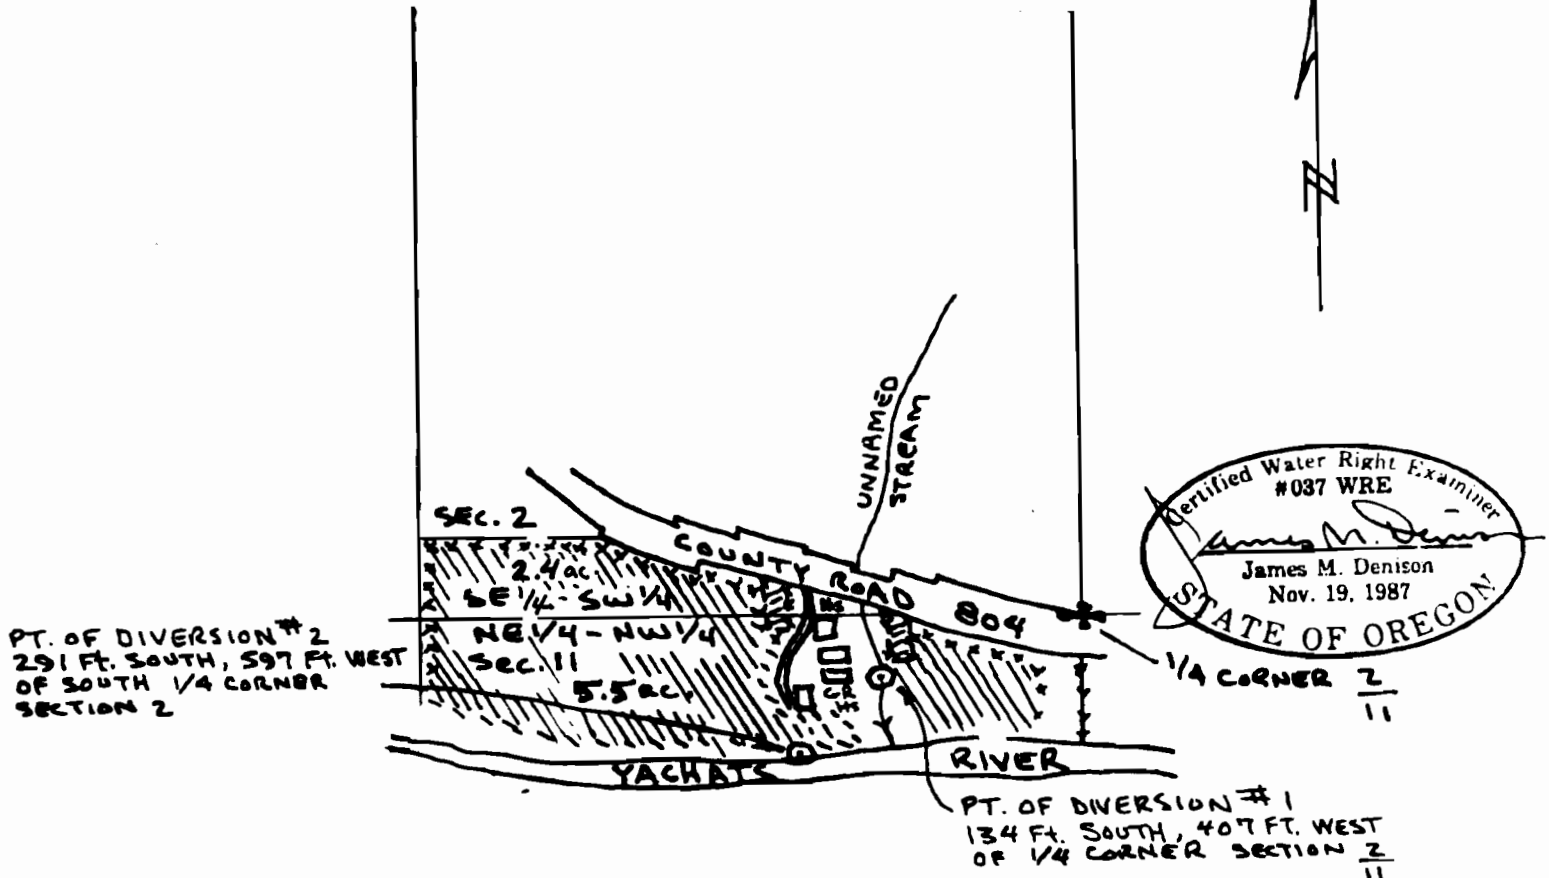

FINAL PROOF SURVEY
UNDER

APPLICATION #70527

PERMIT # 51233

IN THE NAME OF
Verl E. and Ann D. Jensen

SURVEYED: October 16, 1996

BY: J. M. DENISON

THIS MAP PREPARED SOLEY FOR THE PURPOSE OF SHOWING LOCATION OF A WATER RIGHT, AND IS NOT INTENDED FOR USE FOR PROVIDE DIMENSIONS OR LOCATION OF PROPERTY OWNERSHIP LINES.