

RECEIVED

Map of Beneficial Use
Under
APPLICATION G-13115
WATER RESOURCES DEPT.
SALEM, OREGON

AUG 20 1999

in name of

NATE KROFF
29757 Roberts Road
Shedd, OR 97377

Date of Site Inspection: July 23, 1999
Date of Map: August 4, 1999

Tax Lot: 401 (13-3W-8)
Source: A well in the Calapooia River Basin

I, JACK R. BURRELL, BEING DULY SWORN AS A WATER RIGHT EXAMINER, LICENSE NO. 209, HAVE PREPARED THIS MAP FOR NATE KROFF ON THIS 4th DAY OF AUGUST 1999. THE AREAS HATCHED REPRESENT THE LANDS BEING IRRIGATED UNDER THIS PERMIT.


PREPARATION OF THIS MAP IS FOR THE PURPOSE OF IDENTIFYING THE LOCATION OF THE WATER RIGHT ONLY AND HAS NO INTENT TO PROVIDE DIMENSIONS OR LOCATION OF PROPERTY OWNERSHIP LINES.

LEGEND:



PORTION OF PROPERTY TO BE IRRIGATED IS DEFINED BY HATCHING. TOTAL AREA 7.86 ACRES

----- BURIED PVC PIPE IRRIGATION MAINS

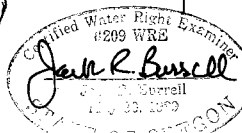

RENEWAL DATE 12/31/99



SW 1/4, NW 1/4

SE 1/4, NW 1/4

SW 1/4, NE 1/4

S.W. CORNER
AMERICUS SAVAGE
D.L.C. 50

T.L. 401

POINT OF DIVERSION:
WELL LOCATED WEST 470'
AND SOUTH 15' FROM THE
S.W. COR. AMERICUS SAVAGE
D.L.C. 50

NW 1/4, SW 1/4

* 1 1/2" PVC

*NOTE: THE LOCATION OF BURIED PVC
PIPE IN THE SOUTH ZONE IS
APPROXIMATE ONLY. THE OWNER
DID NOT KNOW THE PIPING
CONFIGURATION.

T.L. 405

T.L. 404

T.L. 500


T.L. 600

NE 1/4, SW 1/4

NW 1/4, SE 1/4

SW 1/4, SW 1/4

SE 1/4, SW 1/4

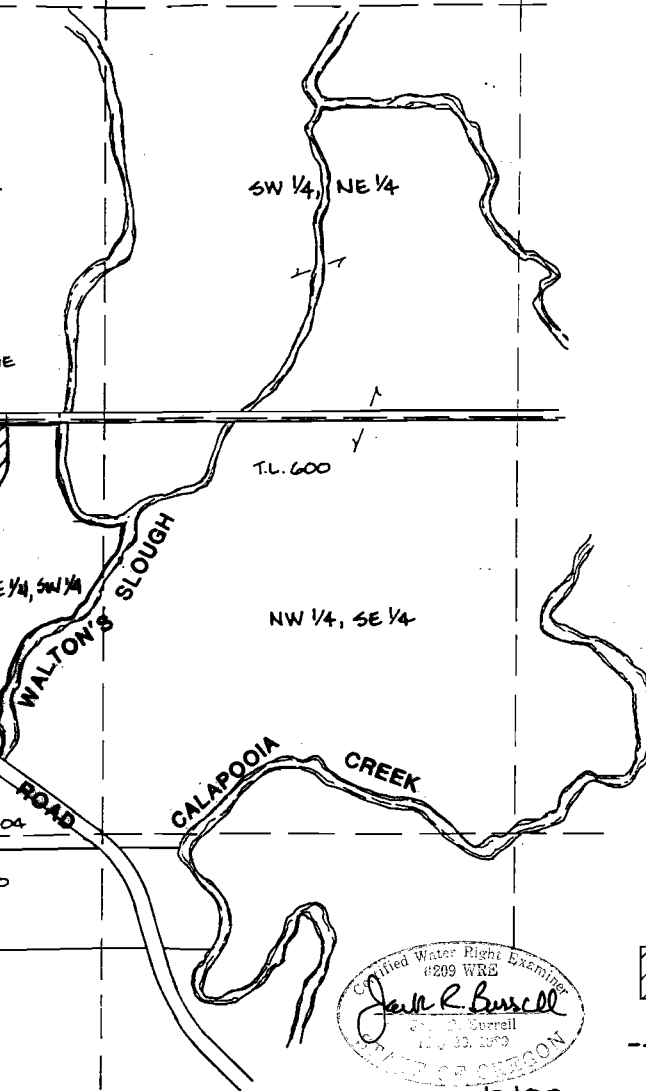

7-8
18 17

KD ENGINEERING, INC.
502 NW HICKORY STREET
POST OFFICE BOX 788
ALBANY, OREGON 97321

KROFF WATER RIGHT
SW 1/4, Sec. 8, T.13S., R.3W., W.M.
LINN COUNTY, OREGON

DSGN. BY: J.R.B.
DWA. BY: J.M.S.
CKD. BY: J.R.B.

SCALE: 1" = 400'
DATE: AUG 4, 1999
PROJECT NO: 92-110

SHEET NO.
1 of 1