

FINAL PROOF SURVEY MAP

RECEIVED

IN THE NAME OF LAURALU G. HORDEN


SEP 13 1999

SECTIONS 23 & 26, T 26 S, R 5 W, W.M.

WATER RESOURCES DEPT.
SALEM, OREGON

APPLICATION 71652

PERMIT 51737

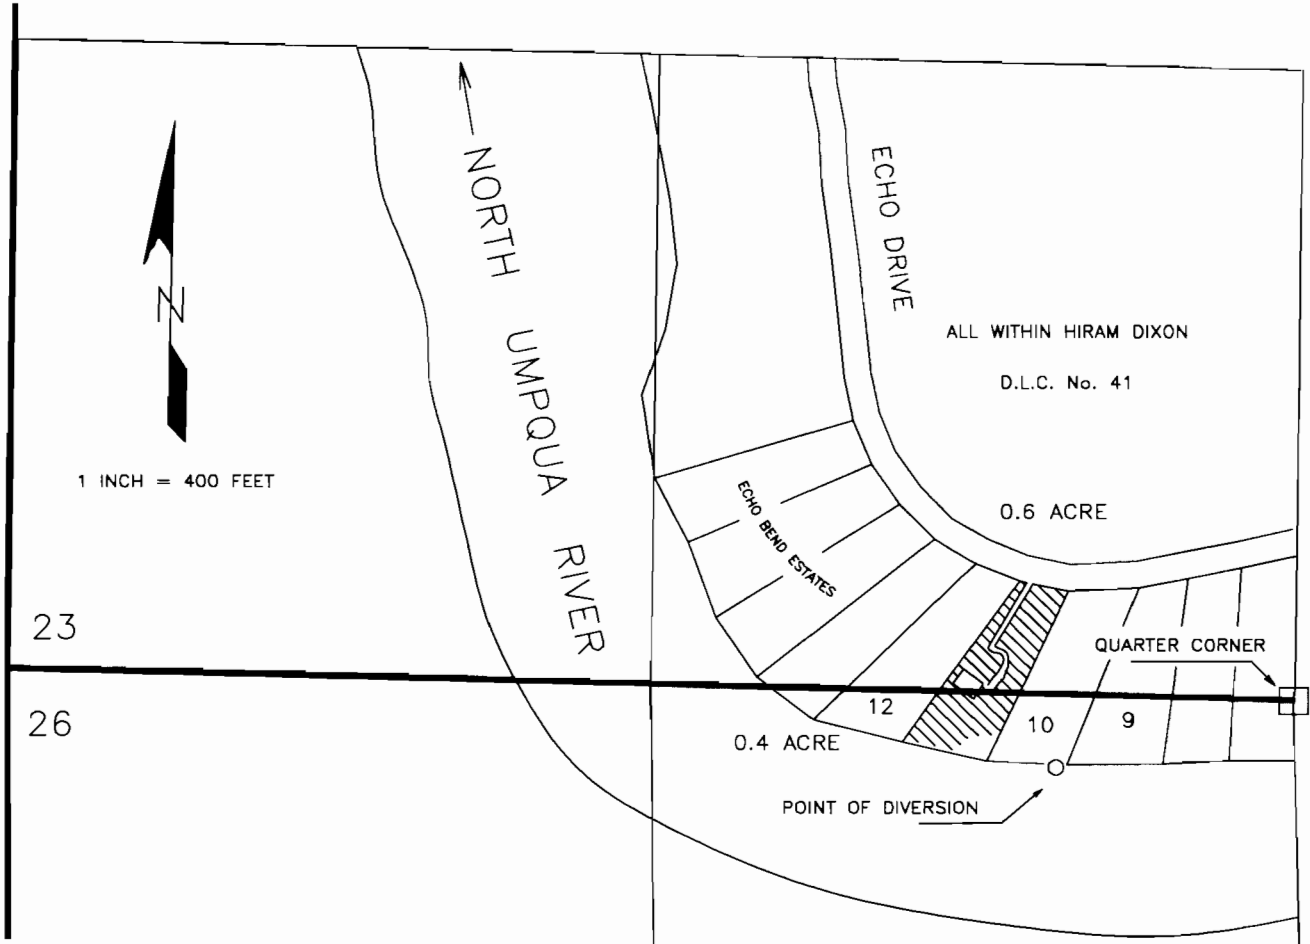

THE POINT OF DIVERSION IS LOCATED 140 FEET SOUTH AND 500 FEET WEST FROM THE NORTH QUARTER CORNER OF SECTION 26, BEING WITHIN THE NE¹/₄NW¹/₄ OF SECTION 26, TOWNSHIP 26 SOUTH, RANGE 5 WEST, W.M.; WITHIN HIRAM DIXON D.L.C. No. 41, DOUGLAS COUNTY.

CERTIFIED WATER RIGHTS EXAMINER
431WRE
Kenna Clay Jordan
KENNA CLAY JORDAN
5-14-96
STATE OF OREGON

THE PURPOSE OF THIS MAP IS TO IDENTIFY THE LOCATION OF THE WATER RIGHT. IT IS NOT INTENDED TO PROVIDE INFORMATION RELATIVE TO THE LOCATION OF PROPERTY OWNERSHIP BOUNDARY LINES.

6-30-01