


RECEIVED

SEP 08 2000


T. 9S., R. 40E., W.M.

WATER RESOURCES DEPT.  
SALEM, OREGON

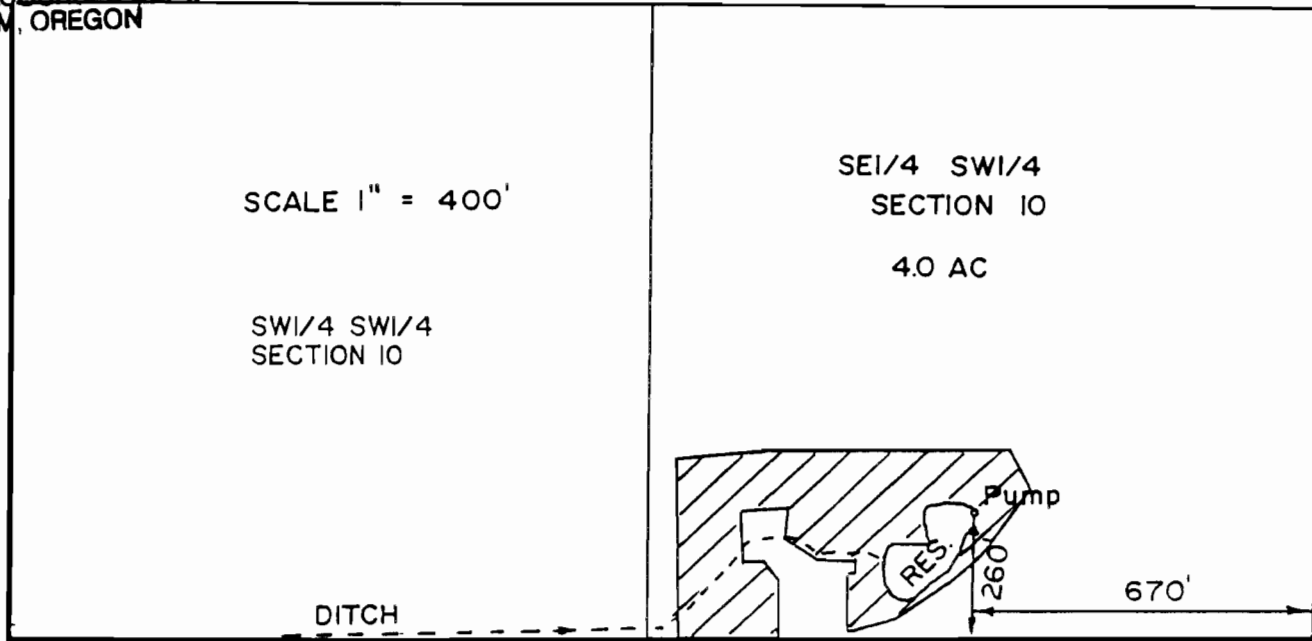

The purpose of this map is for identifying the location of the water right only and is not intended to provide legal dimensions of property ownership lines.

16

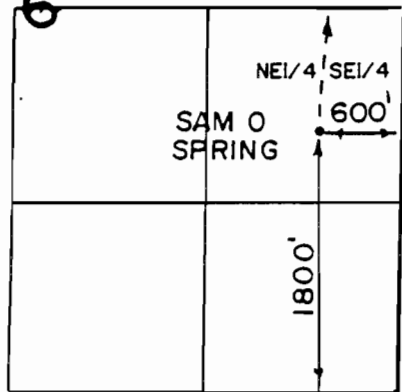

SCALE 1" = 1320'

# FINAL PROOF SURVEY

APPL. R-72331  
72332

PER. R-11876  
52492

IN NAME OF  
Harold & Beverly Staten

Surveyed Aug. 22, 2000

