


T.35 S., R.1 W., W.M.

**RECEIVED**

OCT 02 1997

WATER RESOURCES DEPT.  
SALEM, OREGON

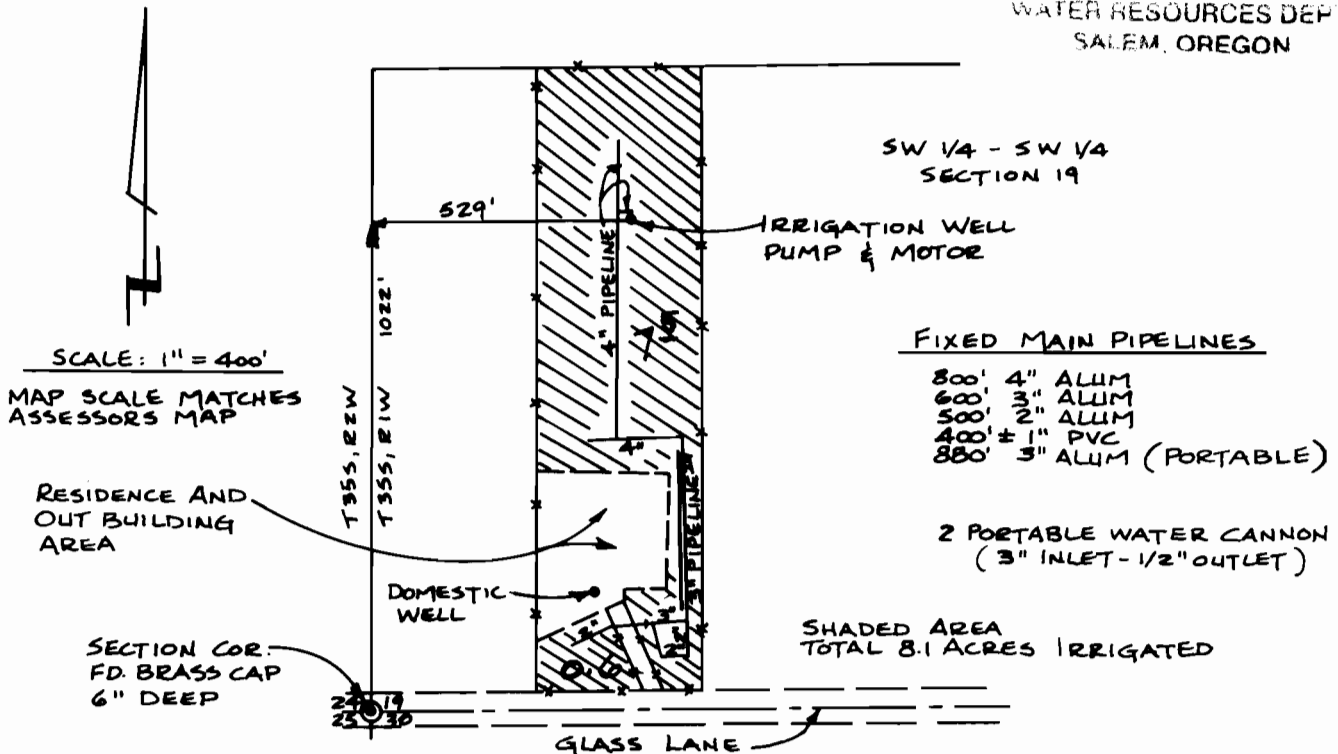

FINAL PROOF MAP

APPLICANT

WALLACE E. MARTENS  
715 WEST FIREWEED  
ANCHORAGE, ALASKA  
99503

APPLICATION No. G-12728

PERMIT No. G-11657

DATE: SURVEY COMMENCED 10/16/96  
FINAL FIELD TEST 7/28/97

NOTE: THIS MAP HAS BEEN  
PREPARED FOR WATER  
RIGHT PURPOSES ONLY,  
NOT FOR PROPERTY  
BOUNDARY LOCATIONS.

