


RECEIVED


JAN 16 1997

WATER RESOURCES DEPT.  
SALEM, OREGON

T.7N., R.9W., W.M.  
SECTION 29

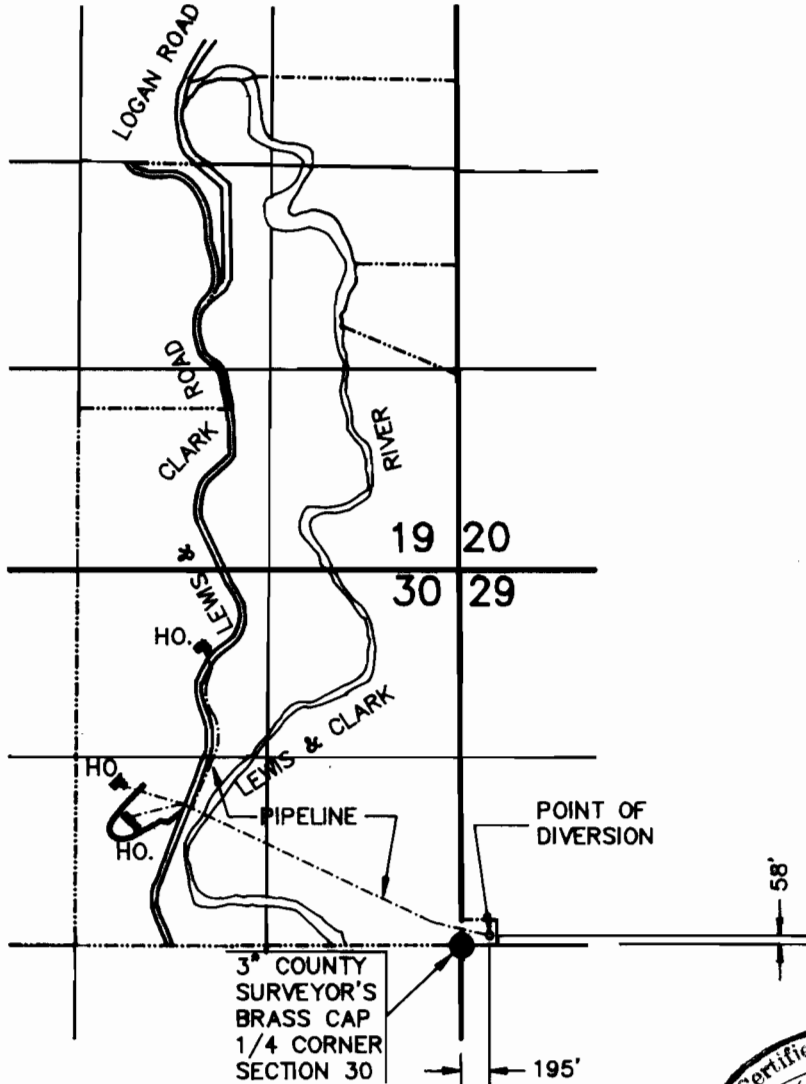

SCALE:  
1" = 1320'

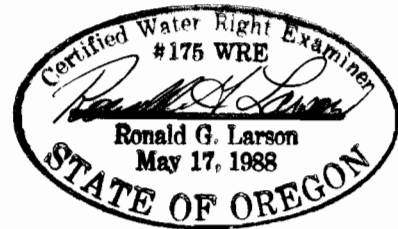

FINAL PROOF SURVEY  
UNDER

APPLICATION NO. 73861, PERMIT NO. 52423

IN THE NAME OF  
JACK BURKHART

SURVEYED OCT. 31, 1996

FILE: 19000201.DWG

**HLB & ASSOCIATES, INC.**  
SURVEYING • ENGINEERING • PLANNING

4253A HWY 101 N.  
GEARHART, OR 97138  
(503) 738-3425  
FAX: (503) 738-7455