


RECEIVED
JUL 28 1999

WATER RESOURCES DEPT.
SALEM, OREGON

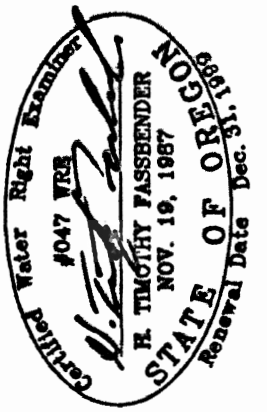

FINAL PROOF SURVEY

THOMAS & JACQUE ROGERS
APP S-10534, PERMIT 51774

SECTION 21 422, TOWNSHIP 16 SOUTH, RANGE 6 WEST, WM.
23640 HALL ROAD, CHESHIRE, OR 97419
JULY 14, 1993

FORD-NESS-FASSBENDER

LAND SURVEYING
CONSTRUCTION SUPERVISION * WATER RIGHTS EXAMINATIONS

P.O. Box 22735
EUGENE, OR 97402

116 Highway 99 N., Ste. 1
Eugene, OR 97402

E-MAIL: FNF@teleport.com

(541) 344-1852
Fax (541) 344-9923

JOB NO. 218601
DWG. NO. JC218601
BY: HIF

SCALE
1" = 400'

N

2.5AC
NE 1/4
SE 1/4
SECTION 21

1/4 COR

HALL ROAD (COUNTY RD 422)

2.5AC
NW 1/4
SW 1/4
SECTION 22

TRUE POINT OF DIVERSION:
913.5' SOUTH & 189.9' EAST
OF THE WEST 1/4 COR
OF SEC 21, T16S R6W WM.



DENOTES AREA OF BENEFICIAL USE

HB

DENOTES HOSE BIB

BURIED 1 1/2"
PVC PIPE

NOTE:
THIS MAP WAS PREPARED FOR THE
PURPOSE OF IDENTIFYING THE
LOCATION OF THE WATER RIGHT ONLY.
IT IS NOT INTENDED TO PROVIDE
DIMENSIONS OR LOCATION
OF PROPERTY OWNERSHIP LINES.