


Township 9 S., Range 31 E., W.M.

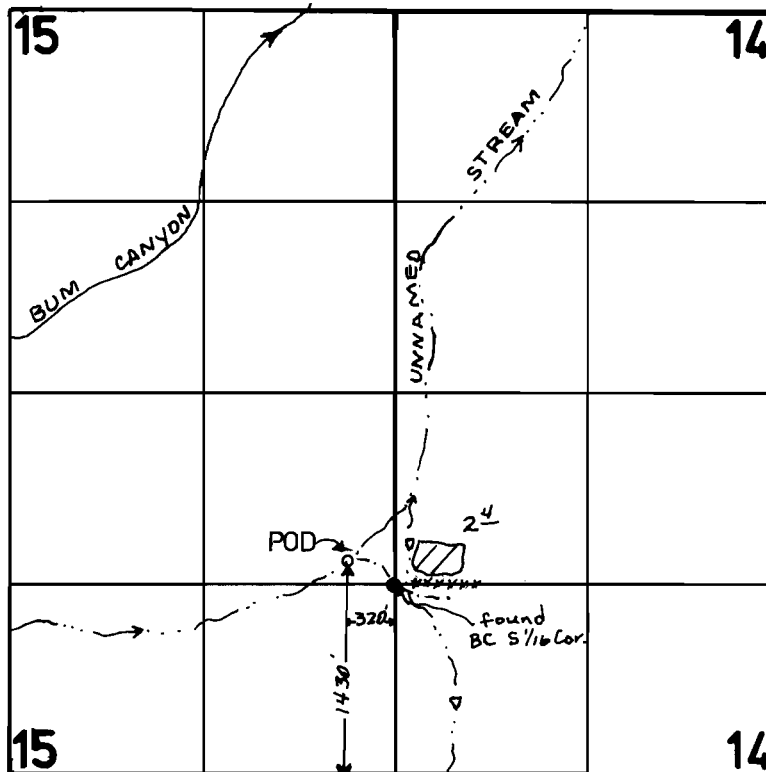

1"= 1320'

FINAL PROOF SURVEY
UNDER

Application No. 69053 Permit No. 50070
IN NAME OF

James L. Dyckhoff

Surveyed Oct 7, 1999, by J. Miller