


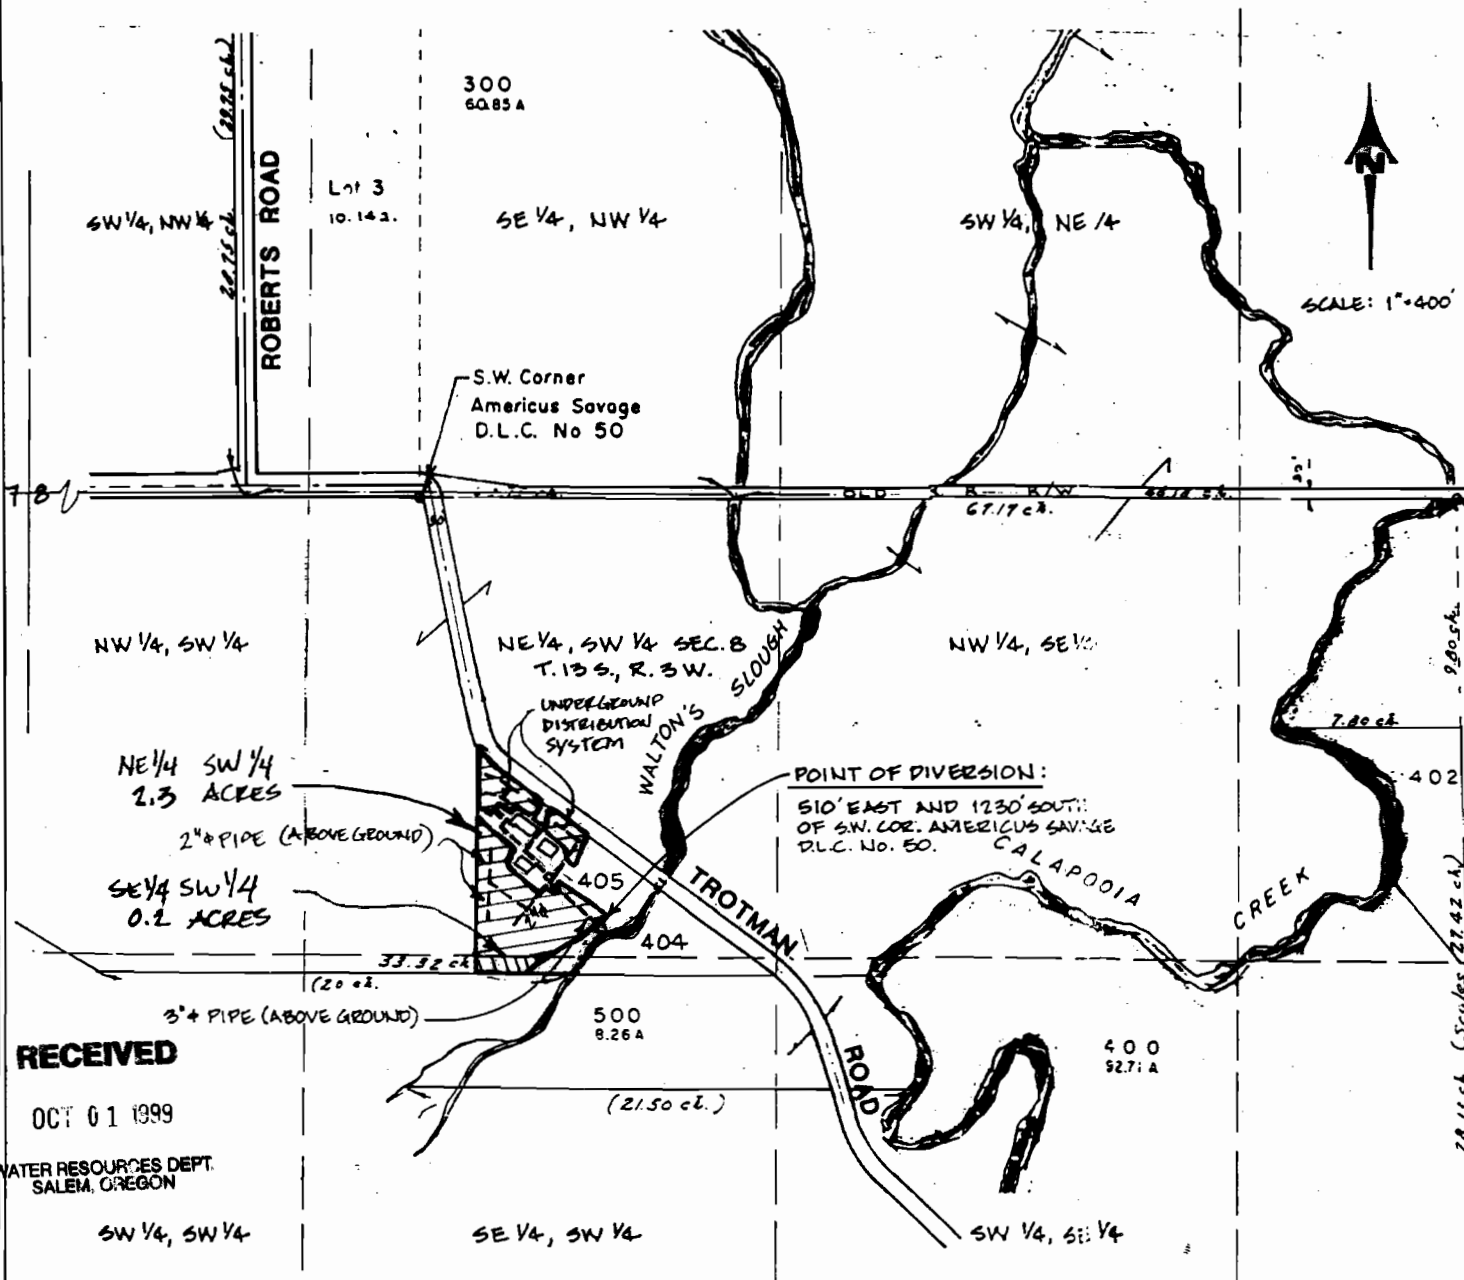

Map of Beneficial Use
under
APPLICATION S-72480
in the name of
DARRYL and LINDA JONES
29722 Roberts Road
Shedd, OR 97377


Date of Site Inspection: September 29, 1999
Date of Map: September 30, 1999
Location: Located in Section 8, Township 13 South,
Range 3 West, Willamette Meridian, Linn County, Oregon.

Area of Irrigation

Under S-72480, there are 2.5 acres begin put to beneficial use as specified by quarter-quarter sections on the herein attached map.

I, JACK R. BURRELL, BEING DULY SWORN AS A WATER RIGHT EXAMINER, LICENSE NO. 209, HAVE PREPARED THIS MAP FOR DARRYL and LINDA JONES ON THIS 30TH DAY OF SEPTEMBER 1999. THE AREAS SHADED REPRESENT THE ACREAGE'S BEING IRRIGATED AT THE TIME OF THE SITE INSPECTION CONDUCTED ON SEPTEMBER 29, 1999.

PREPARATION OF THIS MAP IS FOR THE PURPOSE OF IDENTIFYING THE LOCATION OF THE WATE RIGHT ONLY AND HAS NO INTENT TO PROVIDE DIMENSIONS OR LOCATION OF PROPERTY OWNERSHIP LINES.

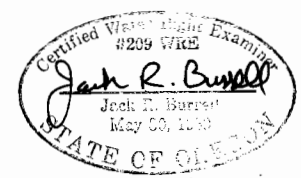

RENEWAL DATE 12/31/99

RECEIVED
OCT 01 1999
WATER RESOURCES DEPT.
SALEM, OREGON

KD ENGINEERING, INC.
808 NW HICKORY STREET
POST OFFICE BOX 728
ALBANY, OREGON 97321

JONES WATER RIGHT
SW 1/4, Sec. 8, T. 13 S., R. 3 W., W.M.
LINN COUNTY, OREGON

DSGN. BY:	SCALE: 1"=400'
DWG. BY: M.M.S./RR	DATE: SEPT. 30, 1999
CKD. BY: J.E.D.	PROJECT NO: 92-74

SHEET NO.
**ONE
OF
ONE**