

FINAL PROOF SURVEY

for JACK ROSS

under Application # 71978 & Permit # 51573


in the NW $\frac{1}{4}$, NE $\frac{1}{4}$, Section 6

T 41 S, R 13 W, W.M.

Curry County, Oregon

scale: 1" = 400'

July, 1997

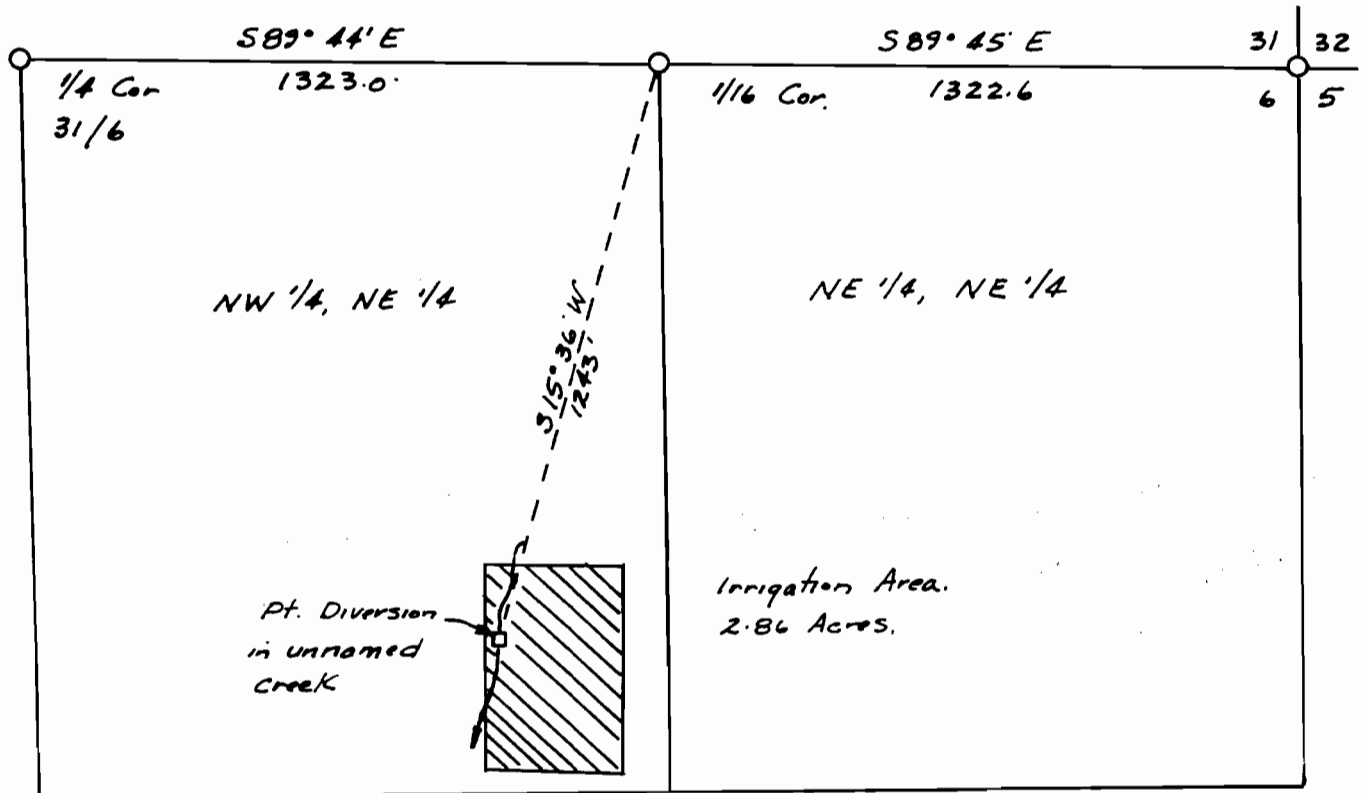

The purpose of this map is to identify the location of a water right. It is not intended to give information relative to the location of property ownership lines.



Donald Cormack, CWRE
P.O. Box 1280
Brookings, Oregon