


T.5N., R.10W., W.M.
SECTION 32

RECEIVED

SEP 17 1999

WATER RESOURCES DEPT.
SALEM, OREGON

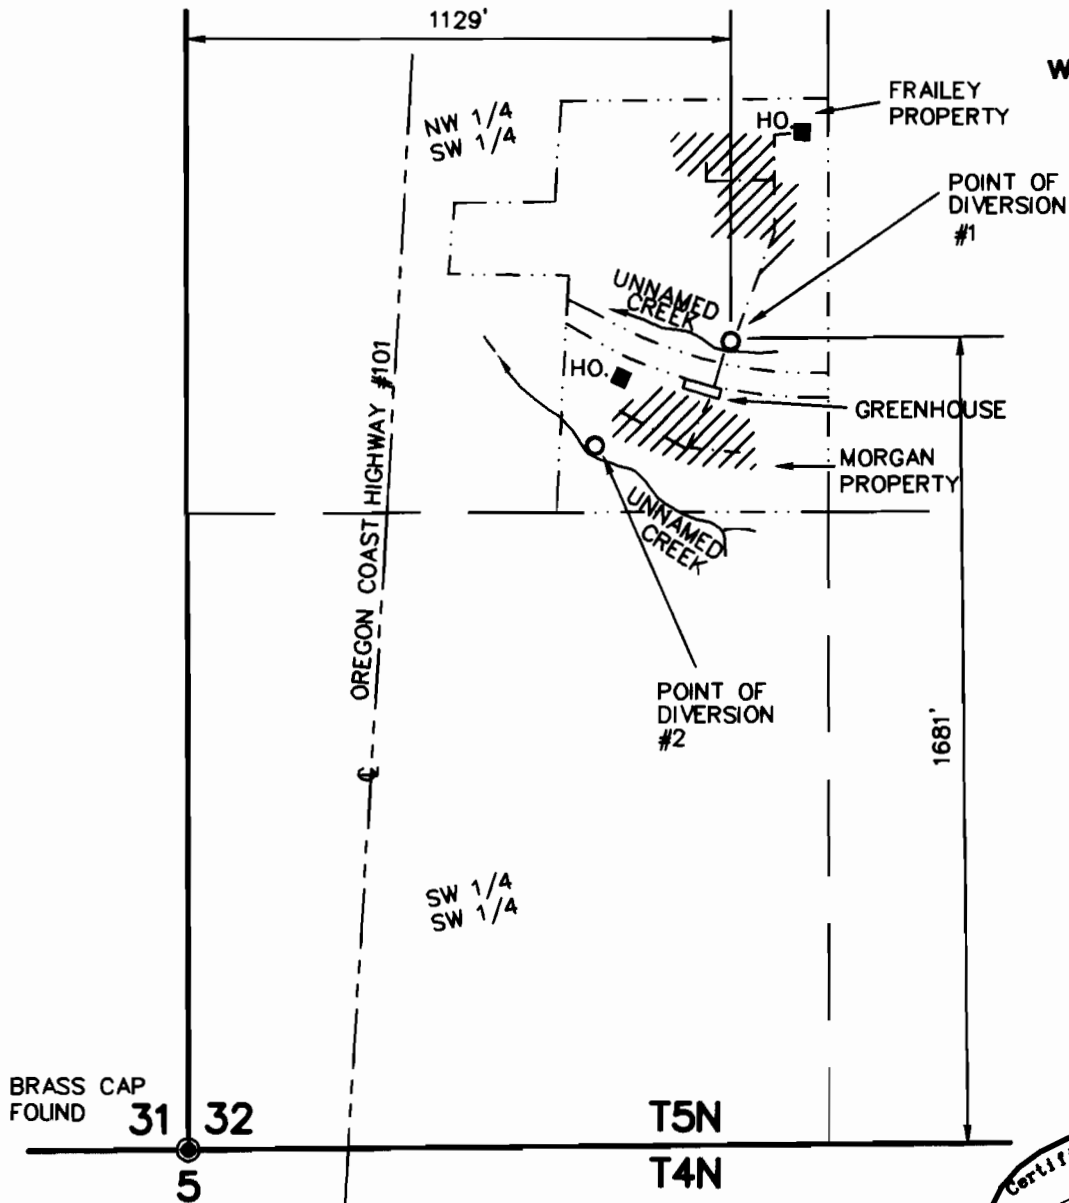

SCALE:
1" = 400'

FINAL PROOF SURVEY

UNDER


APPLICATION NO. 71759

PERMIT NO. 51602

IN THE NAME OF

MIKE MORGAN/ BETH HOLLAND
RITA AND MICHAEL FRAILEY

SURVEYED MARCH 24, 1999

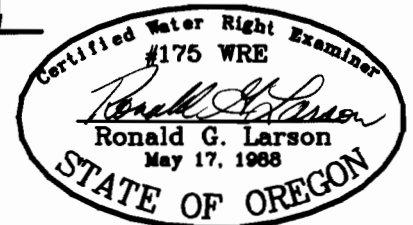

RENEWAL DATE: DECEMBER 31, 2000

FILE: 30100301.DWG

HLB & ASSOCIATES, INC.
SURVEYING • ENGINEERING • PLANNING

160 LANEDA AVE.
MANZANITA, OR 97130
(503) 368-5394
FAX: (503) 368-5847

4253A HWY 101 N.
GEARHART, OR 97138
(503) 738-3425
FAX: (503) 738-7455