


FINAL PROOF SURVEY MAP  
IN THE NAME OF GERALD P. BLACK


APPLICATION S-69771

PERMIT 52007

TOWNSHIP 18 SOUTH, RANGE 3 WEST, W.M.

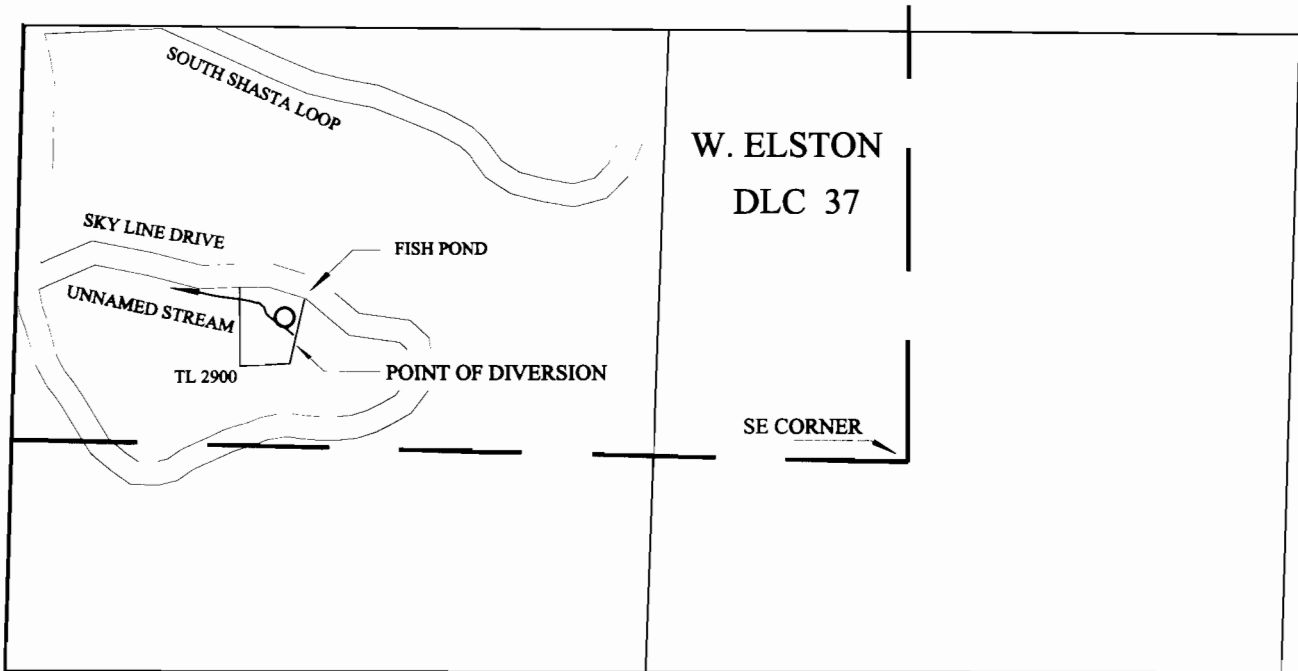

16

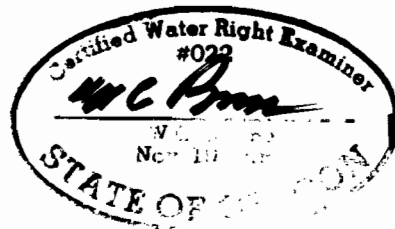

RECEIVED

OCT 04 2000

WATER RESOURCES DEPT.  
SALEM, OREGON

THE POINT OF DIVERSION IS LOCATED 295 FEET NORTH AND 1290 FEET WEST FROM THE SOUTHEAST CORNER OF W. ELSTON D.L.C. No. 37, BEING WITHIN THE NW $\frac{1}{4}$ SW $\frac{1}{4}$  OF SECTION 16, TOWNSHIP 18 SOUTH, RANGE 3 WEST, W.M.

THE PURPOSE OF THIS MAP IS TO IDENTIFY THE LOCATION OF THE WATER RIGHT. IT IS NOT INTENDED TO PROVIDE INFORMATION RELATIVE TO THE LOCATION OF PROPERTY OWNERSHIP BOUNDARY LINES.