T. 39 S., R. 3 E., W. M.

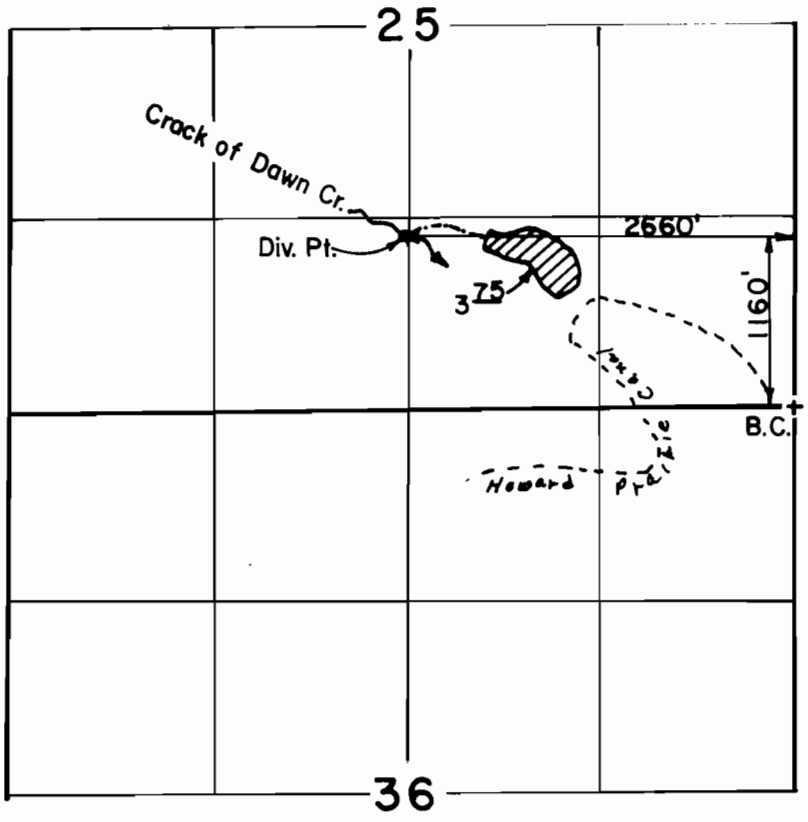

N

Scale: 1" = 1320'

FINAL PROOF SURVEY
UNDER

Application No. 56754 **Permit No.** 42595...
IN NAME OF

.....

Surveyed JULY 30 **19**91., **by** B. S. JAMES...

41039-278-50L

2/92 LMS