

6
7
T18 S.R. 5 W.W.M.
LAKE COUNTY, OREGON

FINAL PROOF SURVEY

UNDER

72734 ^{deb} 51608 ^{deb}
APPLICATION NO. R-72736 PERMIT NO. R-11544

IN NAME OF

LINDA KOHRADY

SURVEYED APRIL 3, 1997 BY: CHARLES W. GUILÉ

PRIORITY DATE

SEPT. 28, 1992


RECEIVED

MAY 19 1997

WATER RESOURCES DEPT
SALEM, OREGON

THIS MAP IS FOR WATER RIGHT
PURPOSE ONLY AND IS NOT
INTENDED TO PROVIDE
DIMENSIONS FOR LOCATING
PROPERTY BOUNDARIES

LOCAL POINT OF DIVERSION
IS 2845.0 FEET SOUTH AND
145.0 FEET EAST OF THE
NORTH 1/4 OF SEC. 7 T.18
S.R. 5 W.W.M.

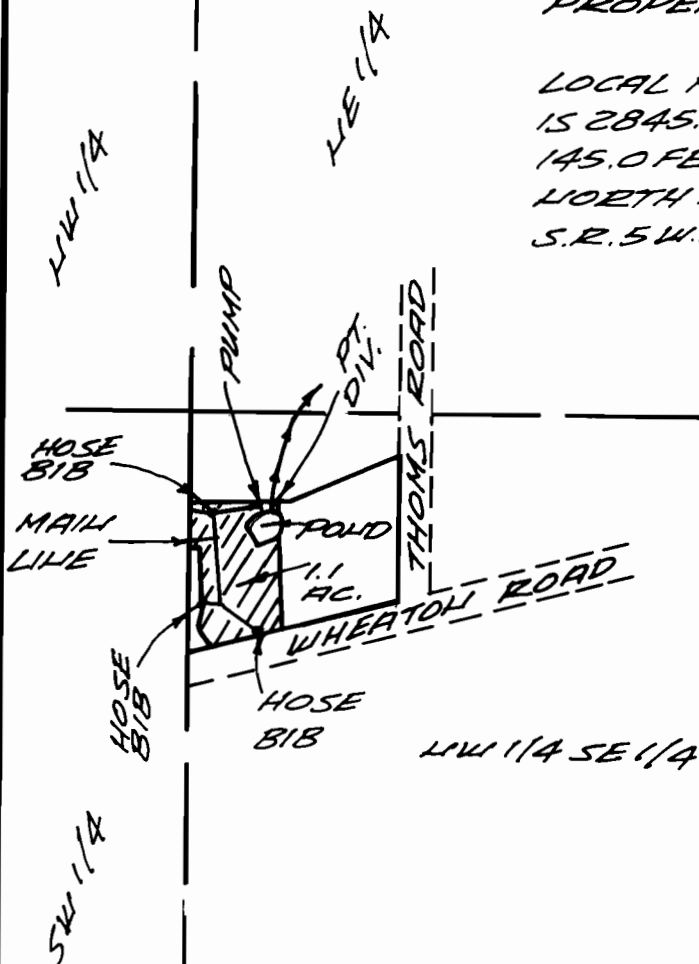

SCALE 1" = 400'



CHARLES W. GUILÉ
& ASSOCIATES, CO.
Land Surveying
52 Centennial Loop
Eugene, OR 97401

92-67