

T. 13 S. & 14 S., R. 37 E., W.M.




SCALE: 1" = 1320'

Positions by hand held GPS

- 1 Stockwater Pond is 240' South and 810' East of the North 1/4 corner Section 4, T. 14 S., R. 37 E.
- 2 Stockwater Pond is 490' North and 630' East of the West 1/4 corner Section 34, T. 13 S., R. 37 E.
- 3 Stockwater Pond is 1940' North and 270' West of the South 1/4 corner Section 34, T. 13 S., R. 37 E.
- 4 Stockwater Pond is 1810' South and 1770' West of the NE corner Section 34, T. 13 S., R. 37 E.
- 5 Stockwater Pond is 520' North and 1550' West of the East 1/4 corner Section 28, T. 13 S., R. 37 E.
- 6 Stockwater Pond is 1200' North and 600' East of the South 1/4 corner Section 28, T. 13 S., R. 37 E.
- 7 Spring is 410' South and 1560' East of the NW corner Section 16, T. 13 S., R. 37 E.
- 8 Spring is 380' North and 1050' East of the SW corner Section 21, T. 13 S., R. 37 E.
- 9 Spring is 80' North and 950' East of the SW corner Section 22, T. 13 S., R. 37 E.
- 10 Spring is 1080' North and 210' West of the SE corner Section 32, T. 13 S., R. 37 E.
- 11 Spring is 40' North and 260' East of the South 1/4 corner Section 32, T. 13 S., R. 37 E.
- 12 Spring is 490' South and 790' West of the NE corner Section 5, T. 14 S., R. 37 E.
- 13 Spring is 220' North and 840' East of the SW corner Section 5, T. 14 S., R. 37 E.
- 14 Spring is 180' North and 290' East of the South 1/4 corner Section 5, T. 14 S., R. 37 E.
- 15 Spring is 940' South and 190' West of the NE corner Section 7, T. 14 S., R. 37 E.
- 16 Stockwater Pond is 320' North and 1560' East of the SW corner Section 5, T. 14 S., R. 37 E.

LEGEND

- Spring/Stockwater Pond Location

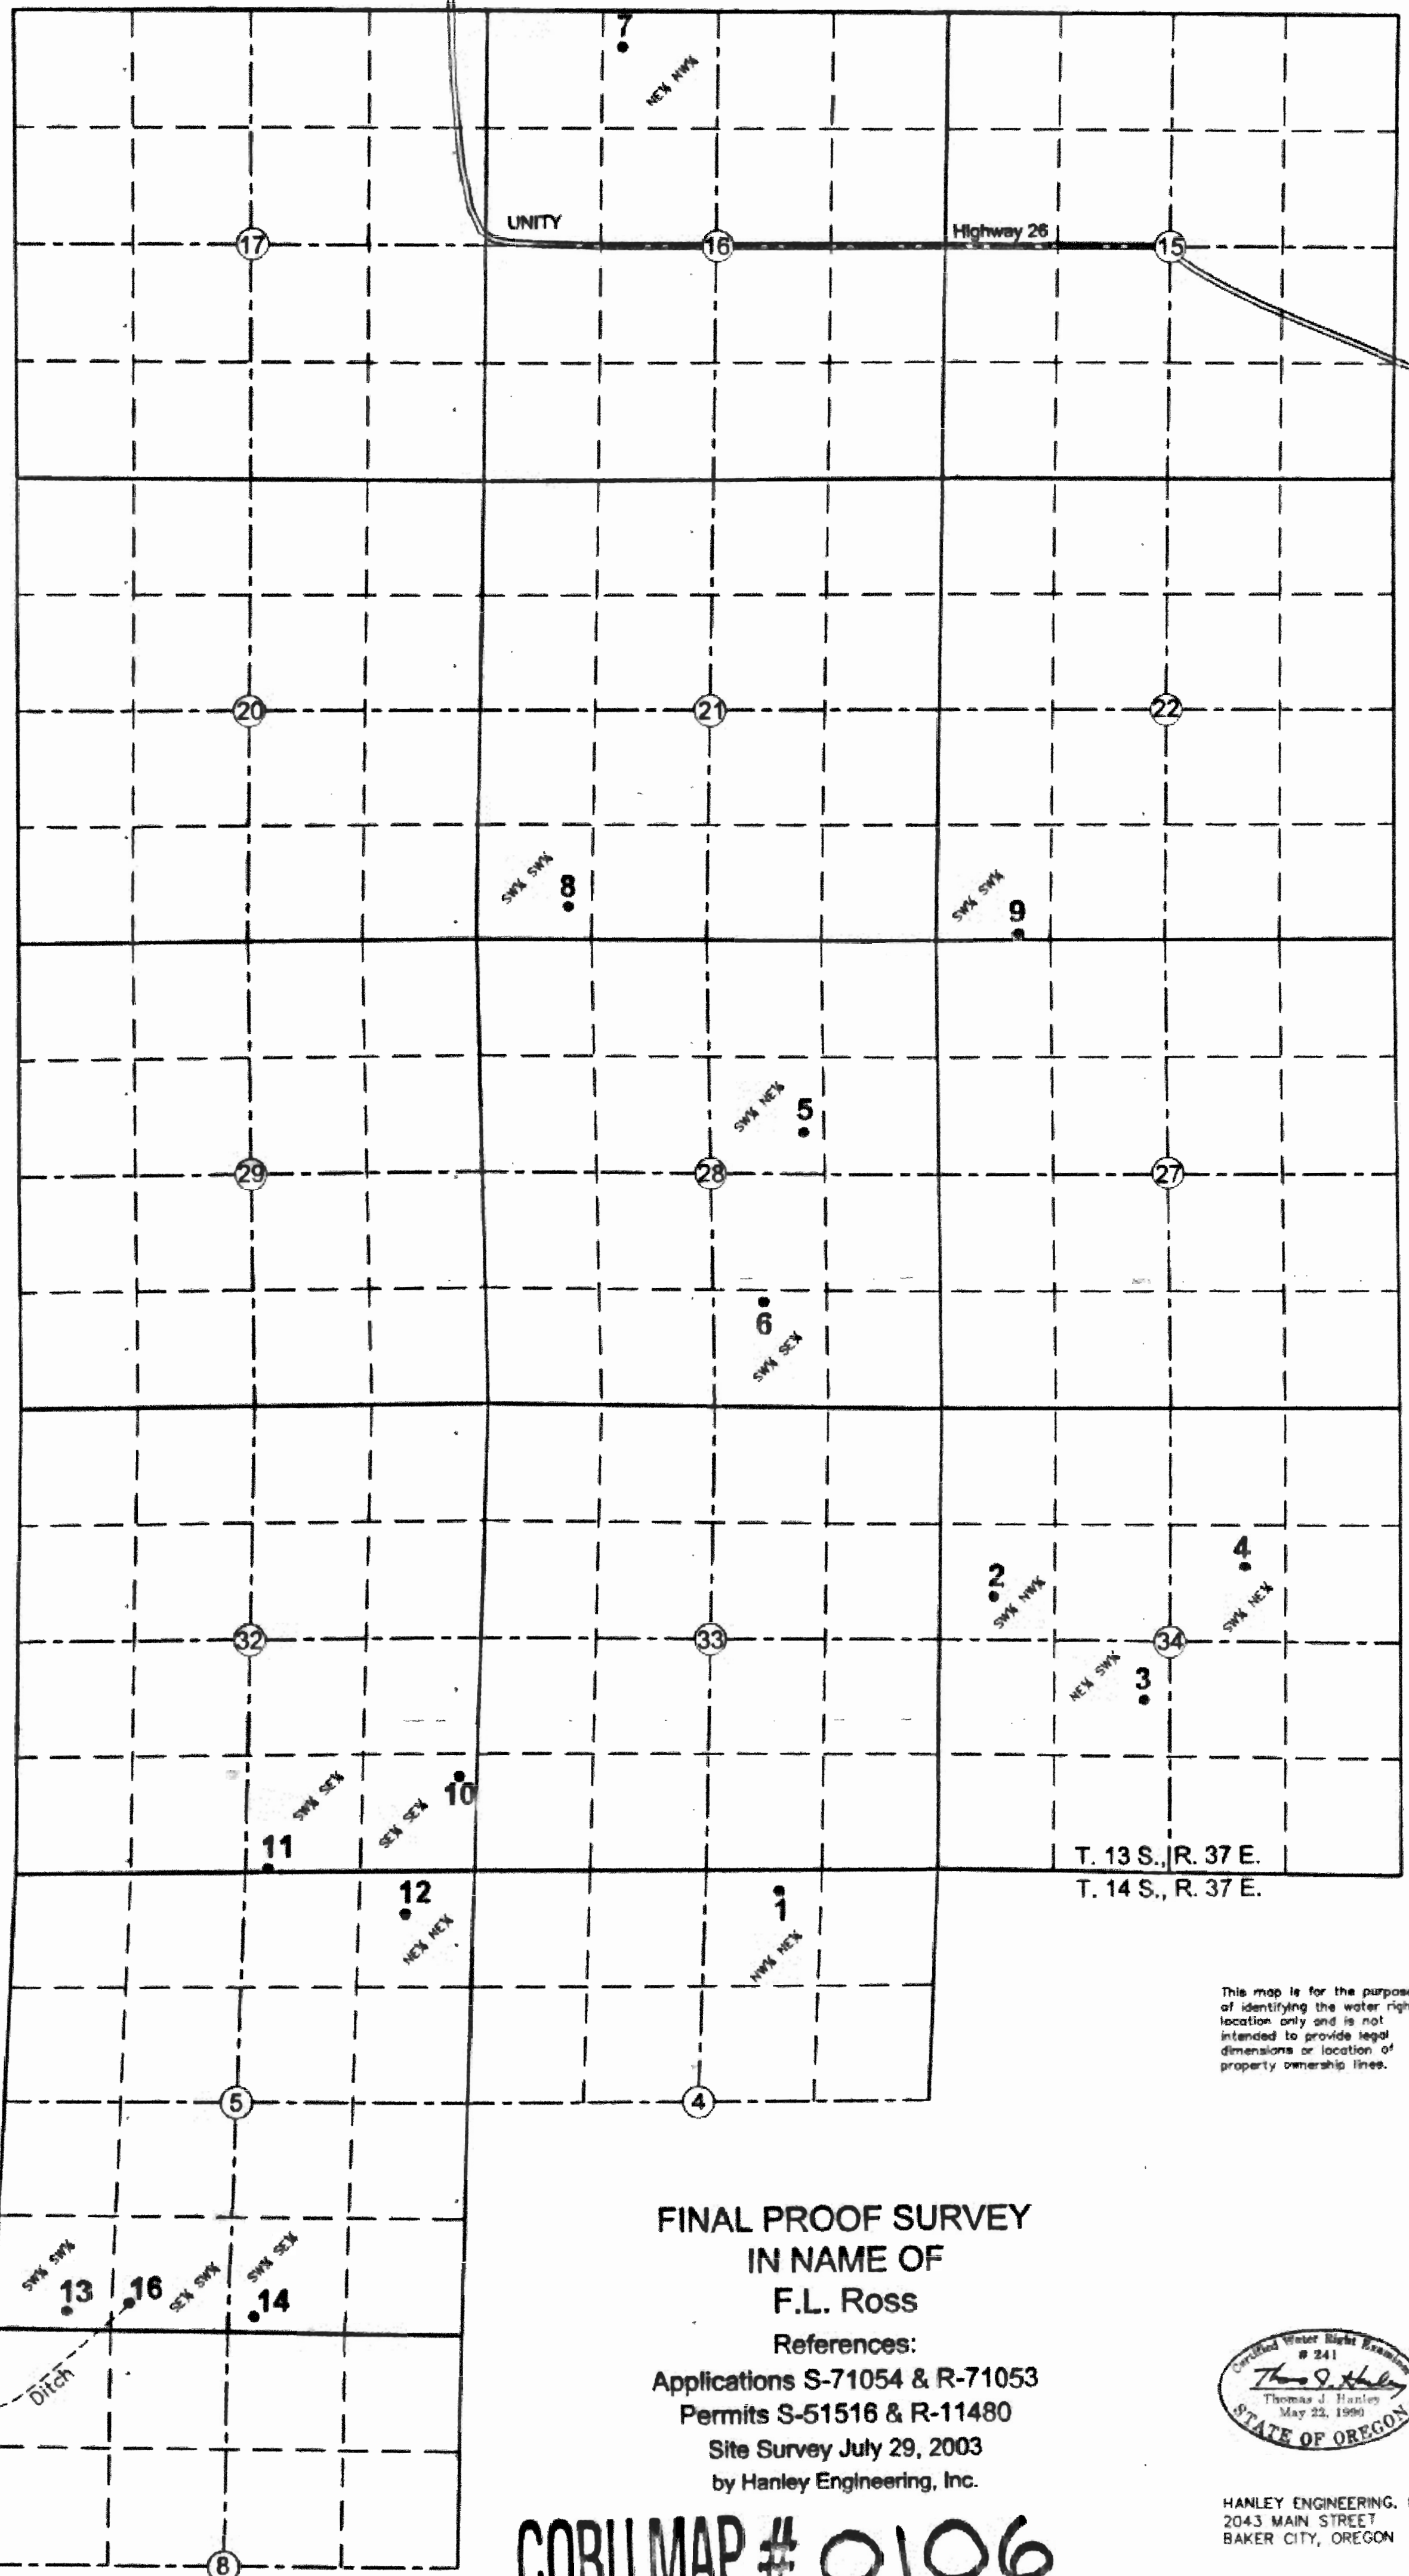

This map is for the purpose of identifying the water right location only and is not intended to provide legal dimensions or location of property ownership lines.

**FINAL PROOF SURVEY
IN NAME OF
F.L. Ross**

References:

Applications S-71054 & R-71053
Permits S-51516 & R-11480
Site Survey July 29, 2003
by Hanley Engineering, Inc.



HANLEY ENGINEERING, INC.
2043 MAIN STREET
BAKER CITY, OREGON

COBU MAP # 0106