


RECEIVED

AUG 03 1998

WATER RESOURCES DEPT.
SALEM, OREGON

TOWNSHIP 20 SOUTH, RANGE 3 WEST, W.M.

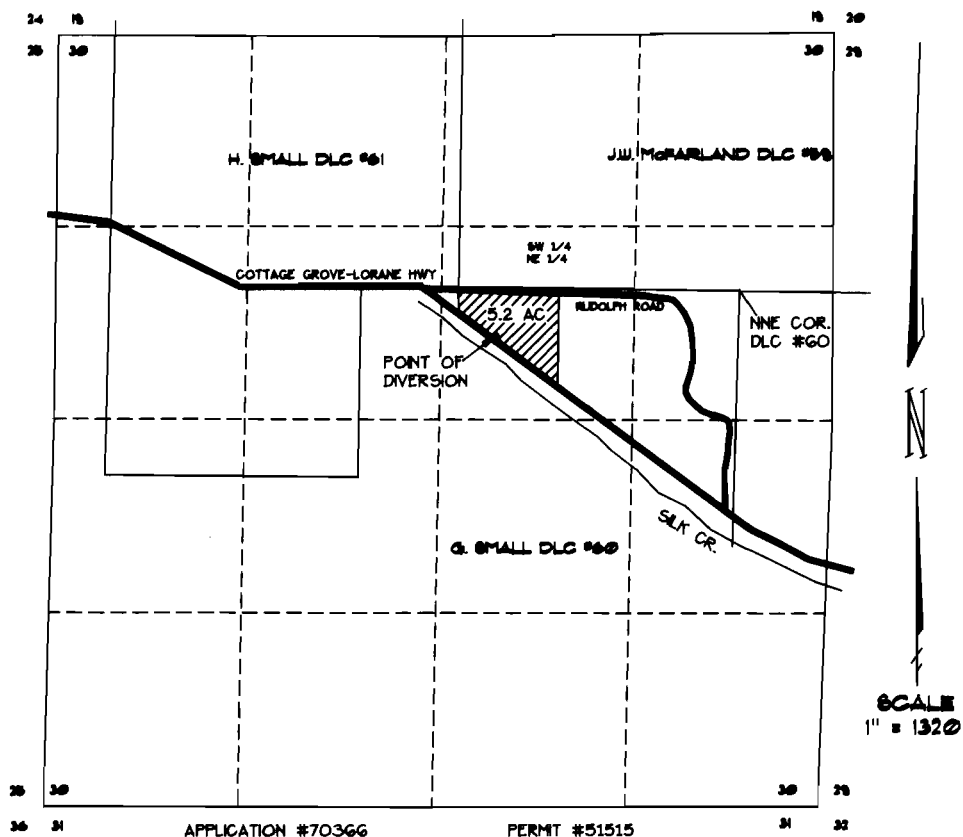

DIVERSION POINT

420.00 FEET SOUTH +
1580.00 FEET WEST OF
THE N.N.E. COR. DLC #60

FINAL PROOF SURVEY

FOR

THOMAS RUSSELL & CHARLOTTE JUNE WOOLCOTT

31516 RUDOLPH ROAD

COTTAGE GROVE, OREGON 97424

PH (541) 842-8051

BY


FORD-NESS-FASSBENDER, INC.

PO BOX 22735

EUGENE, OREGON 97402

PH (541) 344-1852

JULY 20, 1998

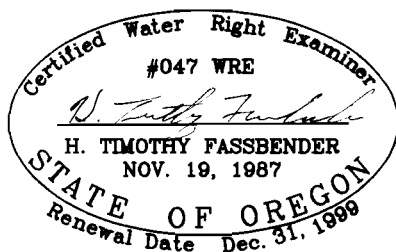

THE PREPARATION OF THIS MAP WAS FOR
THE PURPOSE OF IDENTIFYING THE LOCATION
OF THE WATER RIGHT ONLY. IT IS NOT
INTENDED TO PROVIDE LOCATION NOR
DIMENSION OF PROPERTY OWNERSHIP LINES.

JOB NO. 2368.3
DWG NO. CG2368-3.DWG