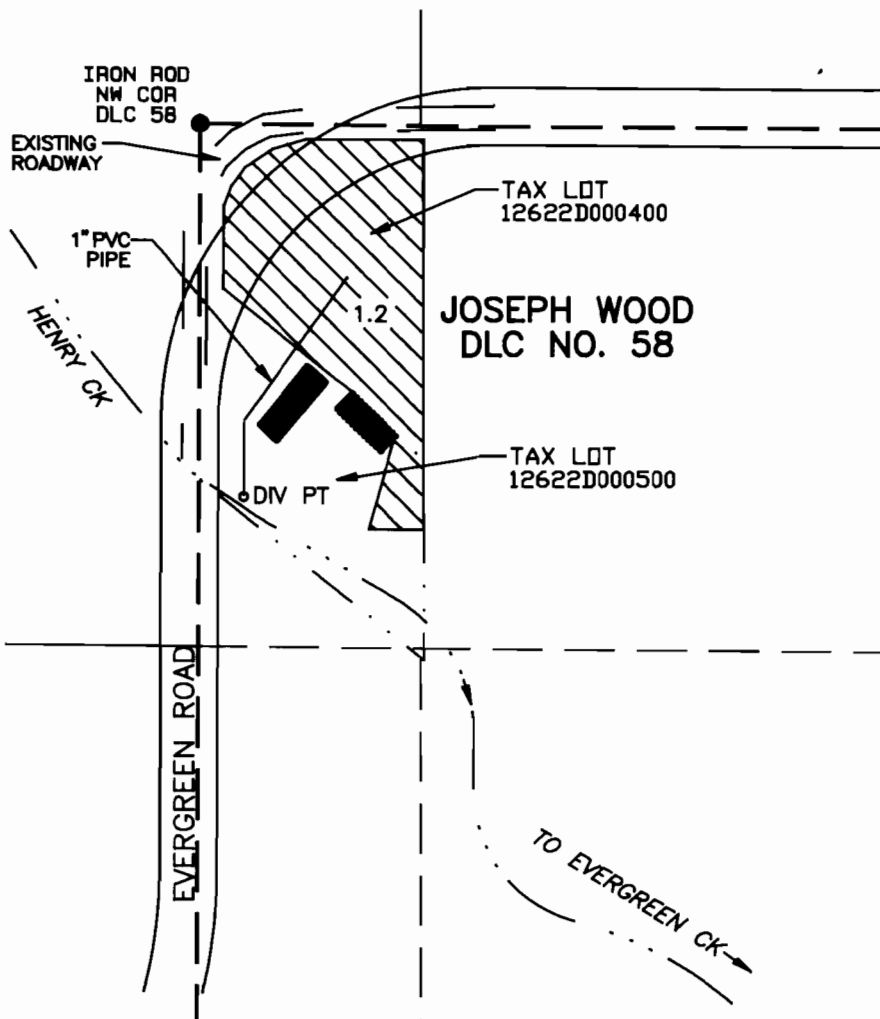


RECEIVED


MAY 12 1999

WATER RESOURCES DEPT.  
SALEM, OREGONT12S, R6W, W.M.  
NE1/4SW1/4 SEC 22

1" = 200'

DIV PT:  
SOUTH 390' & EAST 45' FROM NW CORNER DLC 58**CLAIM OF BENEFICIAL USE MAP**

for

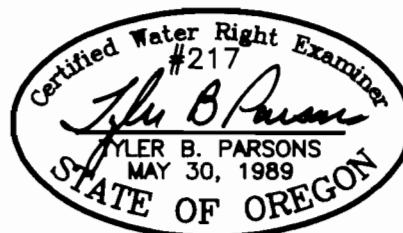**DAVID & DEBORAH MORRIS**

EXP: 12/31/2000

**PARSONS SURVEYING**1915 S.E. Stone St.  
Corvallis, OR 97333  
(541) 752-7515  
Project No. 9918  
4/23/1999This map is for the purpose of locating  
a water right only and is not intended to  
provide legal dimensions or the location  
of property lines.

PERMIT: 51679