



T.9S. R.3W. W.M.

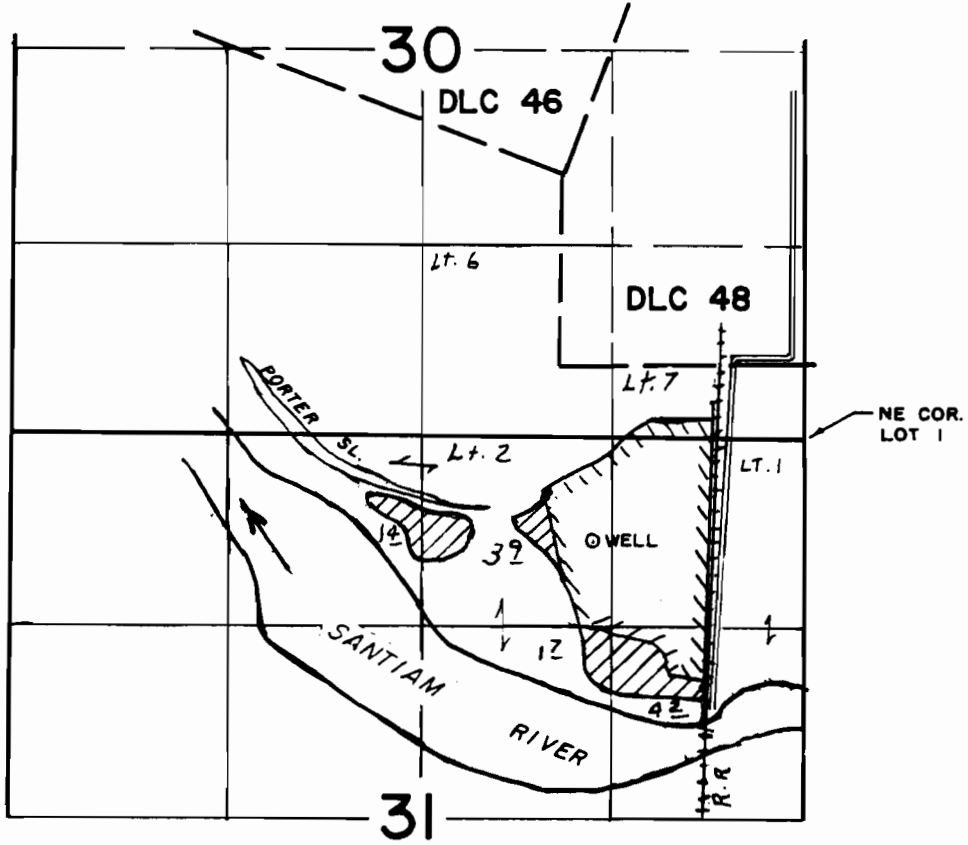

4" = 1 MI.




WELL LOC. 1475' W. & 700' S. FROM NE COR. LOT 1

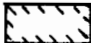 GR 3616 (30 AC.)

FINAL PROOF SURVEY UNDER

Application No. G-14168 Permit No. G-12611
IN NAME OF
DARRELL A. LEARN

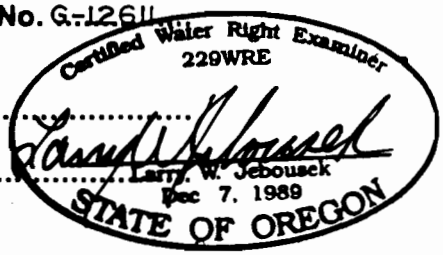

Surveyed DEC. 29 1999, by

THIS MAP WAS PREPARED FOR THE PURPOSE OF IDENTIFYING THE LOCATION OF A WATER RIGHT ONLY AND IS NOT INTENDED TO PROVIDE LEGAL DIMENSIONS OR LOCATION OF PROPERTY OWNERSHIP LINES.