


**FINAL PROOF MAP  
CLAIM OF BENEFICIAL USE**

APPLICATION NO. G-13724

PERMIT NO. G-12368

CLIENT: DON JONES

LOCATED IN SECTION 15  
TOWNSHIP 2 SOUTH, RANGE 4 EAST, W.M.  
CLACKAMAS COUNTY, OREGON  
SCALE: 1" = 400'      MARCH 2, 2004

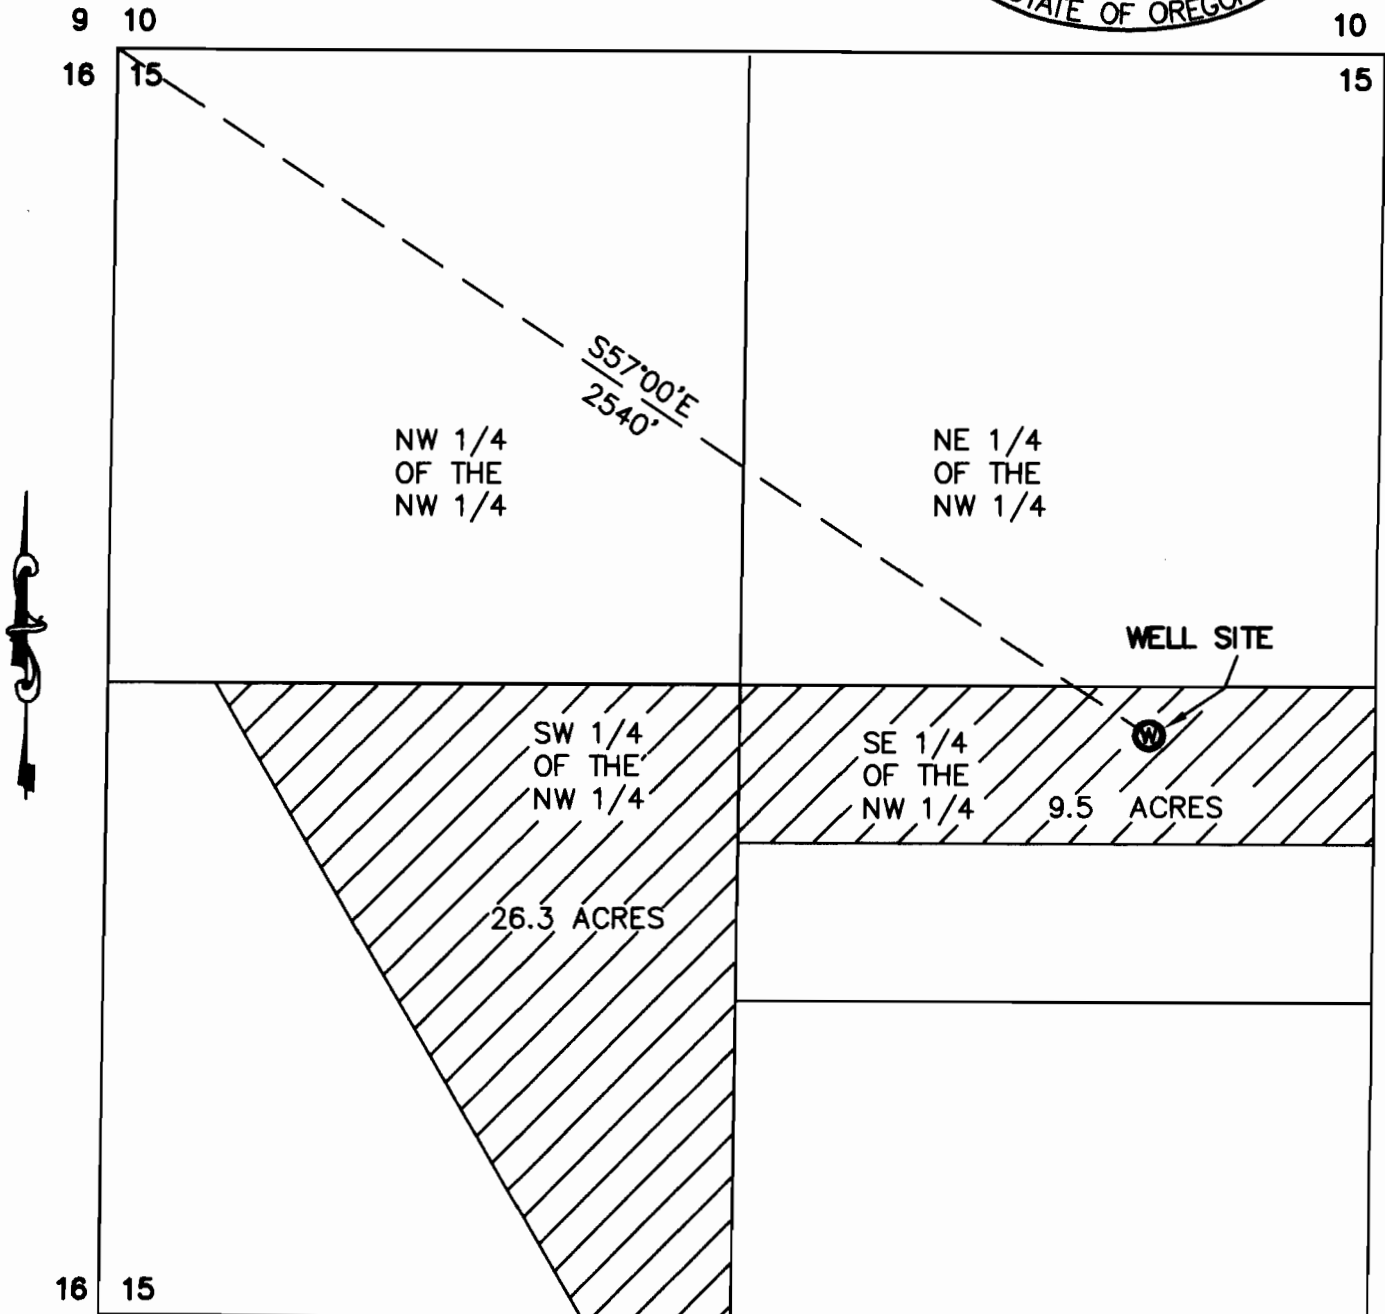

**RECEIVED**

**MAR 05 2004**

**WATER RESOURCES DEPT  
SALEM, OREGON**

THIS DRAWING IS NOT A LAND SURVEY. PROPERTY LINES  
AND/OR OTHER LINES OF OCCUPATION SHOWN HEREON  
ARE NOT REPRESENTED BY THE UNDERSIGNED TO MEET  
ACCURACY STANDARDS OF LAND SURVEYS.



*all*

**COUNTY SURVEYORS  
& PLANNERS, INC.**

P.O. BOX 955  
SANDY, OREGON 97055  
(503) 668-3151

JOB# 04-018