
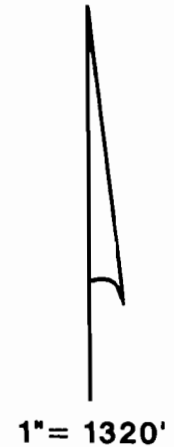


T.8S., R.3W., W.M.

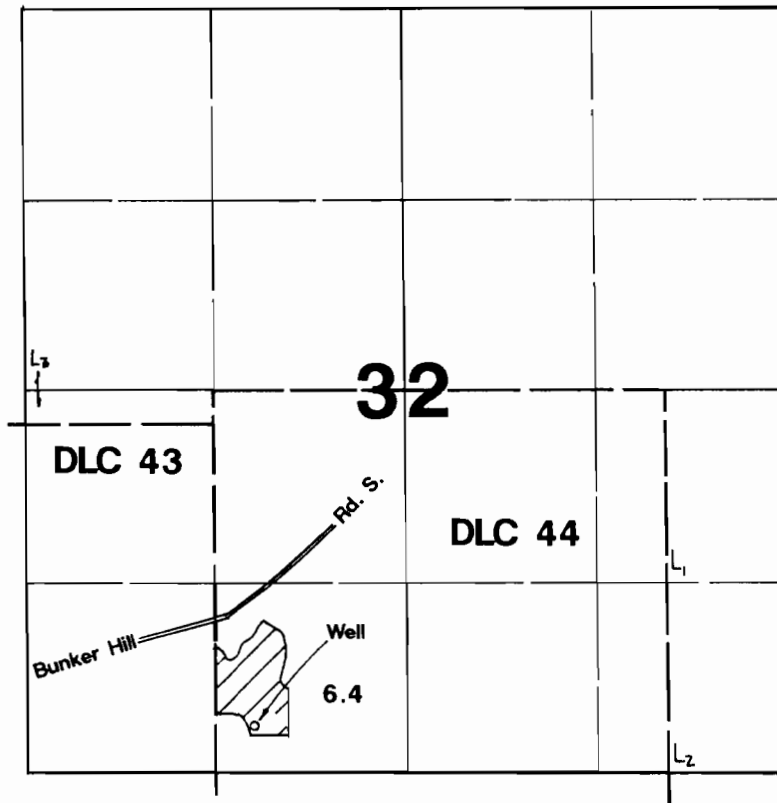

Well located 330'N & 1580'E from SW corner Section 32.

Final Proof Survey

Application #: G-13498 Permit #: G-11709

In Name Of

Donald A. Still

Surveyed on January 6, 1997 by JM Schuette

THIS MAP WAS PREPARED FOR THE PURPOSE OF IDENTIFYING THE LOCATION OF A WATER RIGHT ONLY AND IS NOT INTENDED TO PROVIDE LEGAL DIMENSIONS OR LOCATION OF PROPERTY OWNERSHIP LINES.

